


RECEIVED

OCT 18 1983
WATER RESOURCES DEPT.
SALEM, OREGON

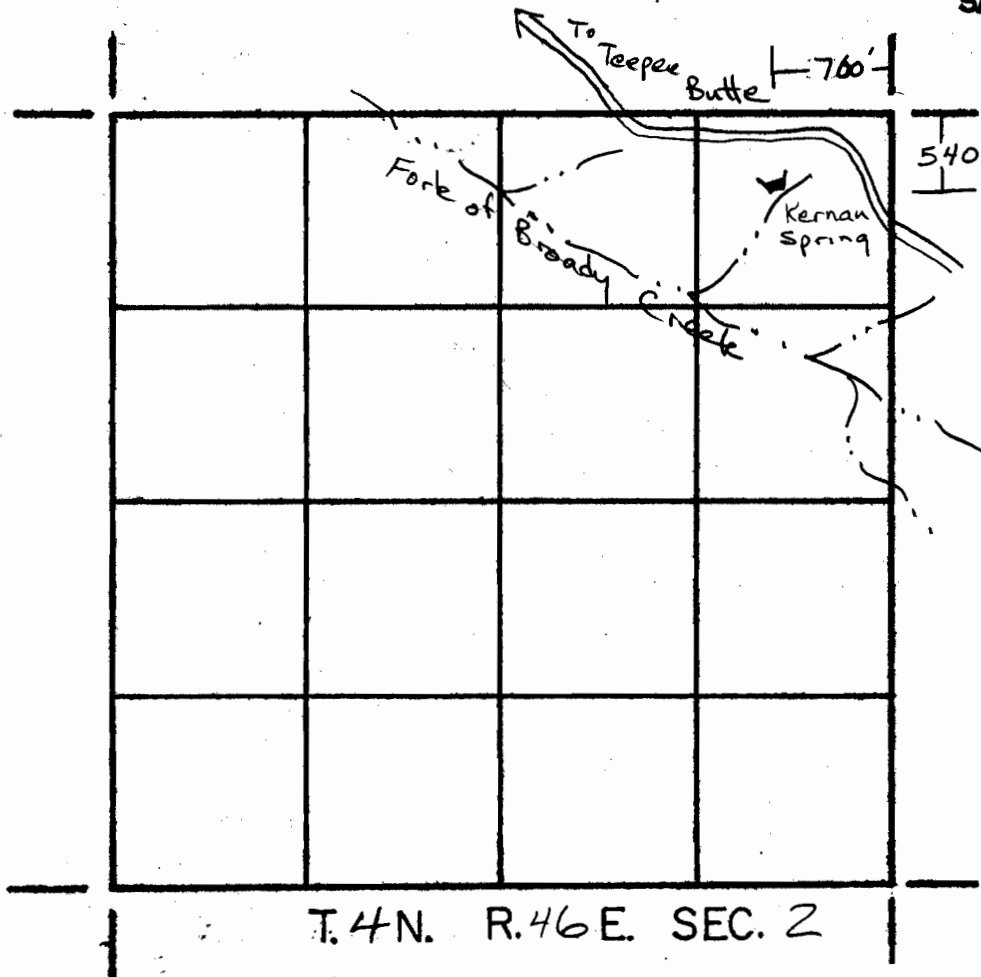

4 Inches = 1 Mile

Application No. 57578
Permit No. 49108

Prepared By _____