


RECEIVED

OCT 13 1983

**WATER RESOURCES DEPT.
SALEM, OREGON**

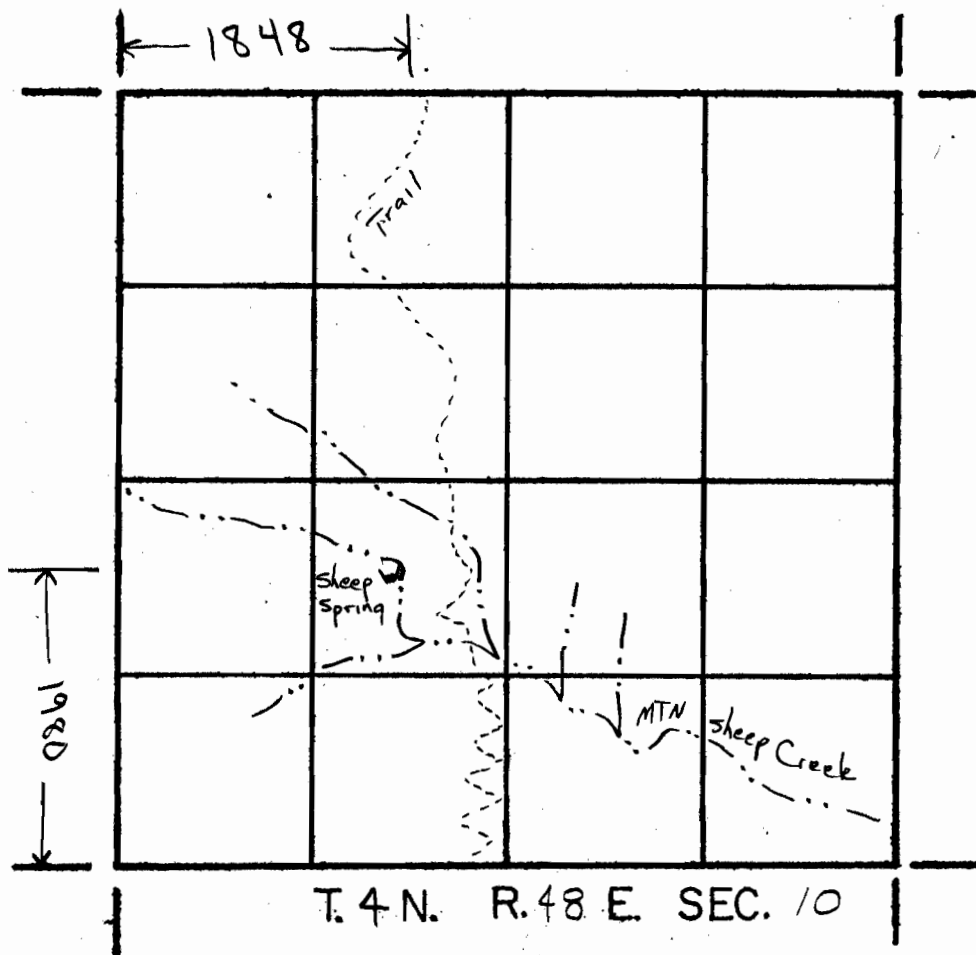

4 Inches = 1 Mile

Application No. 87584
Permit No. 49114

Prepared By Robert J. Barry