


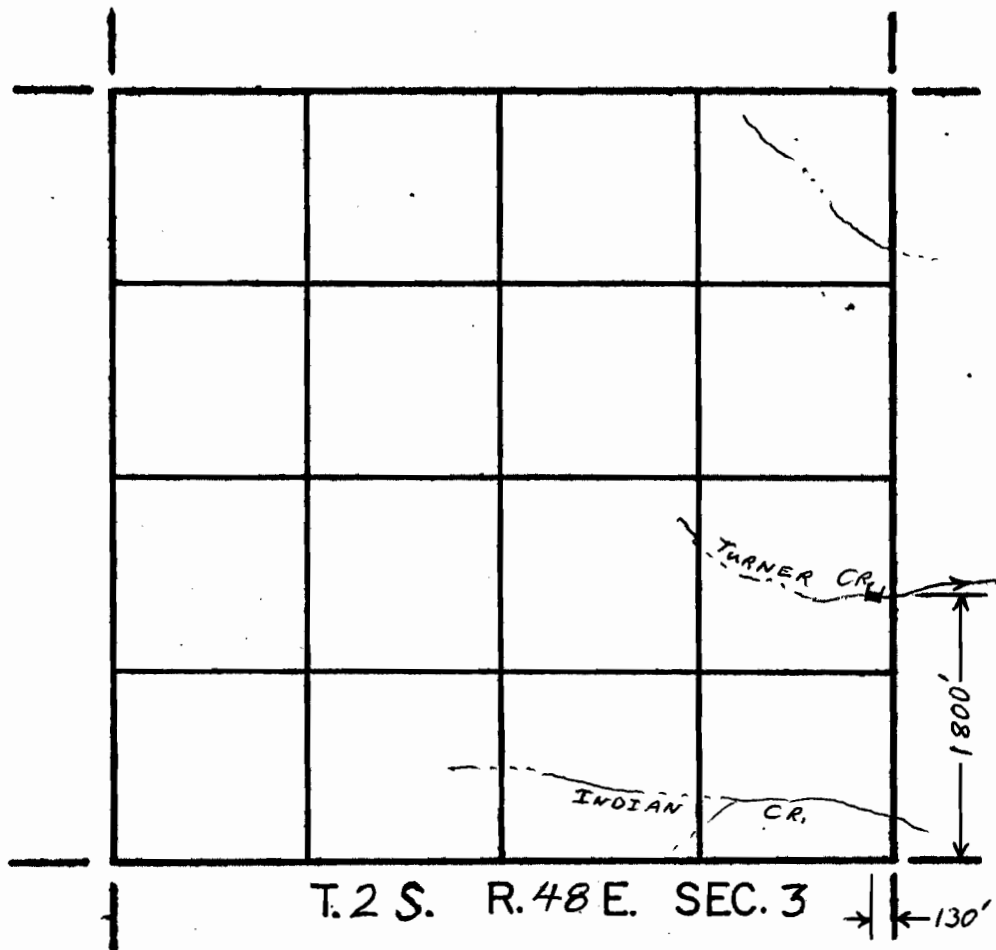

4 Inches = 1 Mile

Application No. 67585
Permit No. 49115

RECEIVED
OCT 18 1983
WATER RESOURCES DEPT.
SALEM, OREGON

Prepared By Shirley L. Ames