


07587

RECEIVED

OCT 13 1983

WATER RESOURCES DEPT.  
SALEM, OREGON

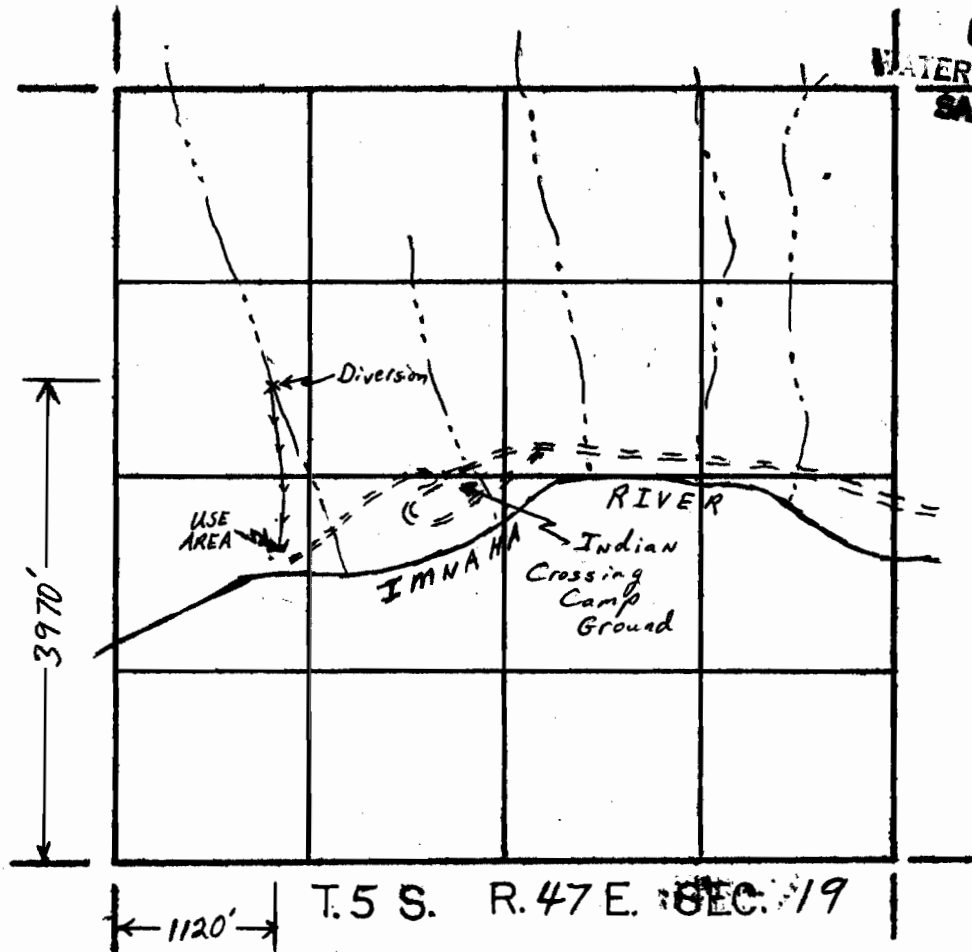

4 Inches = 1 Mile

Application No. 07587  
Permit No. 49117

Prepared By Lloyd L. Ames