


RECEIVED
OCT 18 1983
WATER RESOURCES DEPT.
SALEM, OREGON

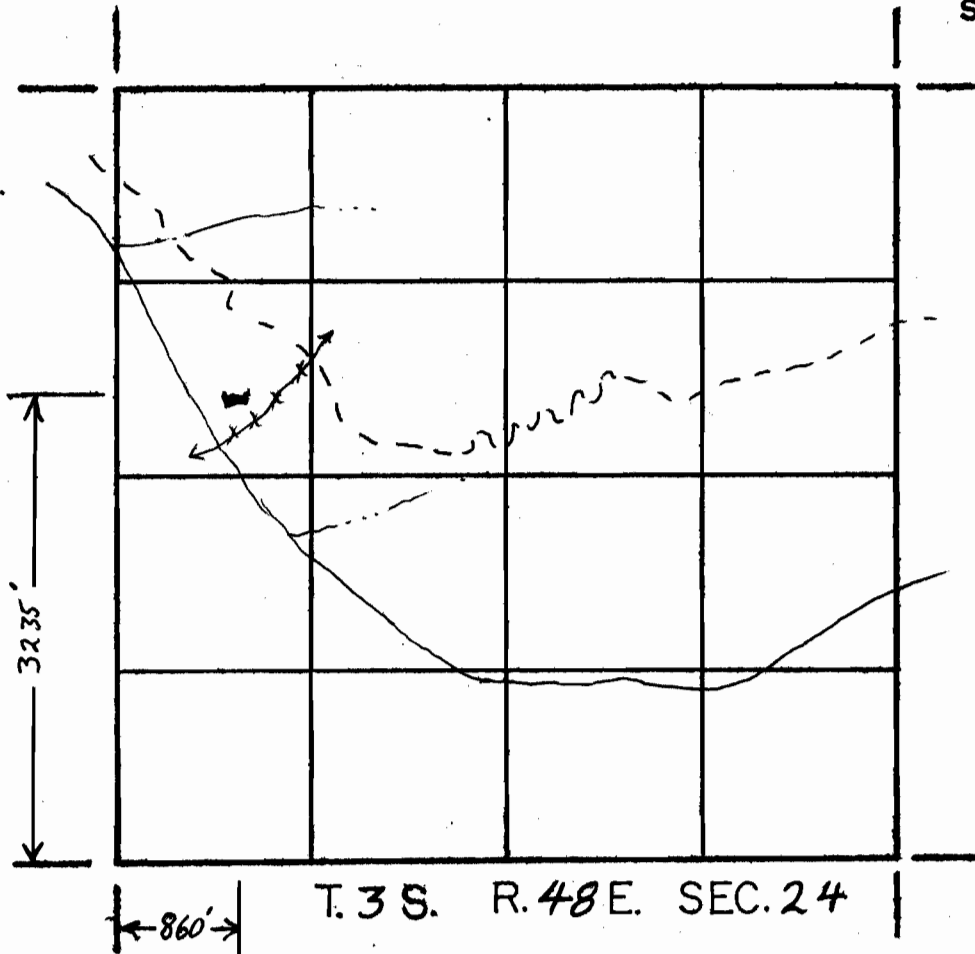

4 Inches = 1 Mile

Application No. 67588
Permit No. 49118

Prepared By Lloyd L. Ames