



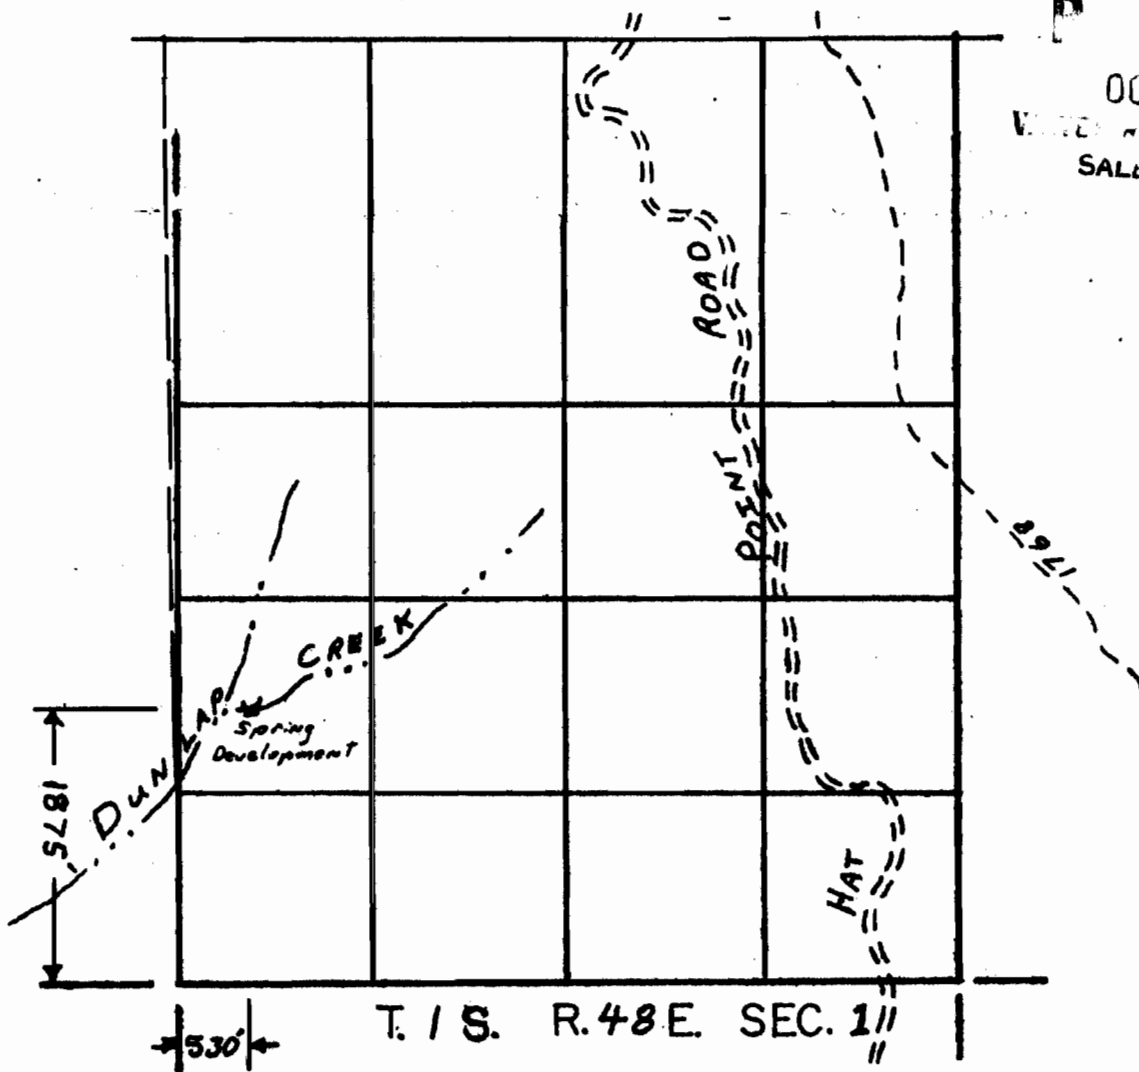

P
ED
007131983
WATER RESOURCES DEPT
SALM. OREGON

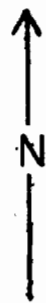

4 Inches = 1 Mile

Application No.
Permit No.

67590

49120

Prepared By _____