


RECEIVED

OCT 18 1983

W. RESOURCES DEPT.
SALM. OREGON

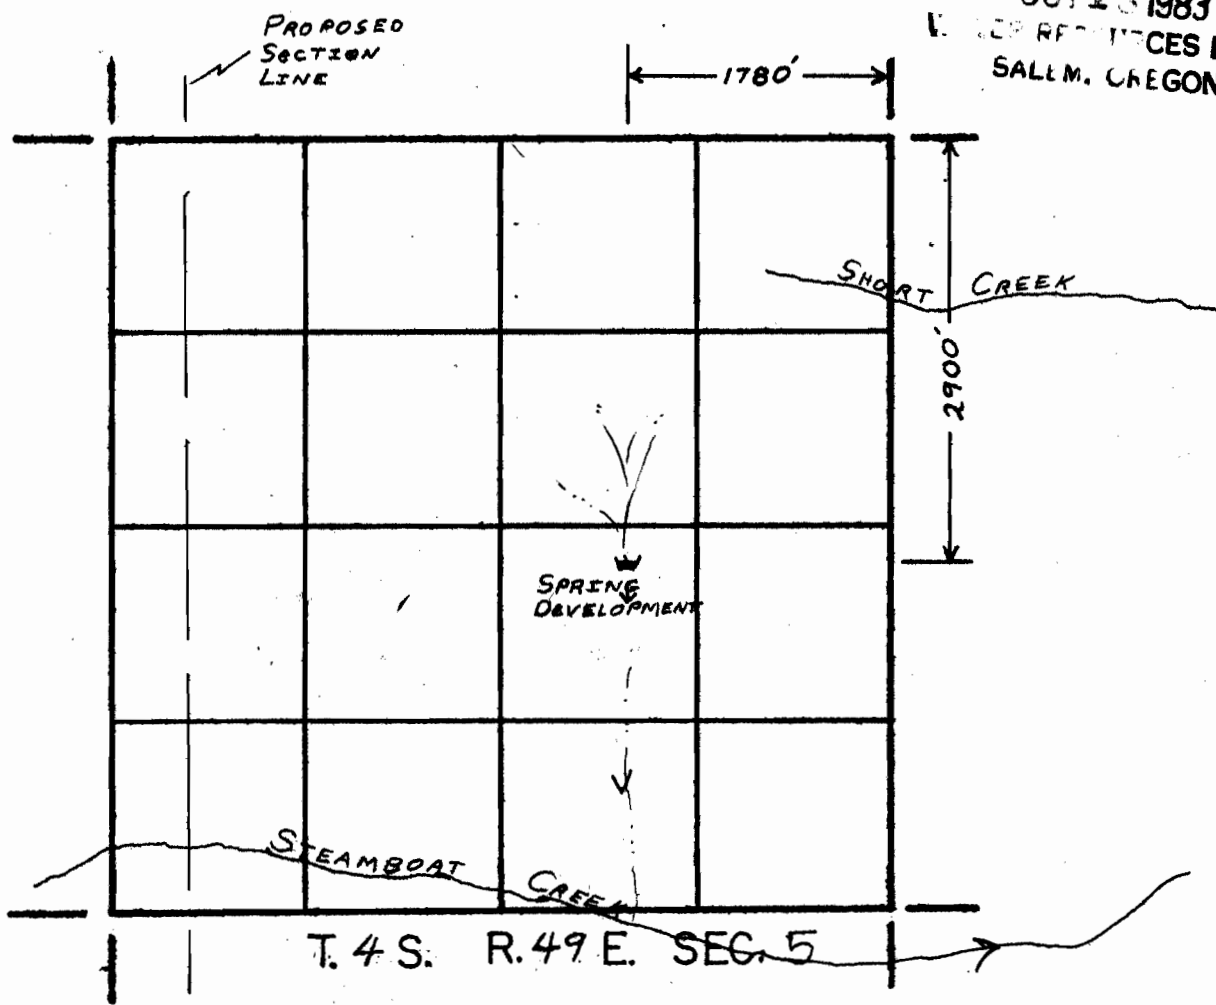

4 Inches = 1 Mile

Application No. 67591
Permit No. 49121

Prepared By Lloyd J. Ames

Steam boat Benches #1