


RECEIVED

OCT 13 1983

WATER RESOURCES DEPT.
SALEM, OREGON

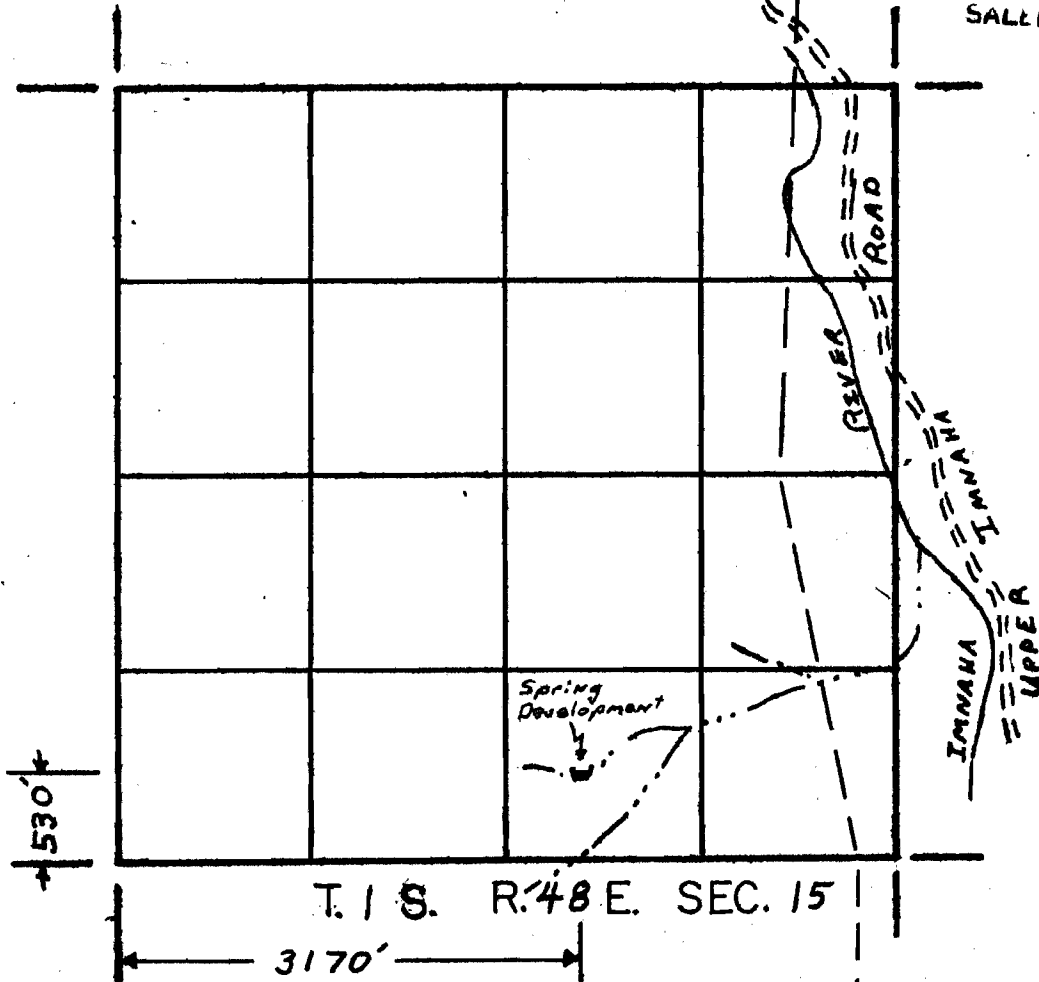

4 Inches = 1 Mile

Application No.
Permit No.

67592
49122

Prepared By Lloyd A. Ames

new trough Dunlap River