
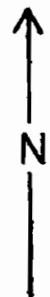


RECEIVED

OCT 18 1983

WATER RESOURCES DEPT.
SALEM, OREGON

7754

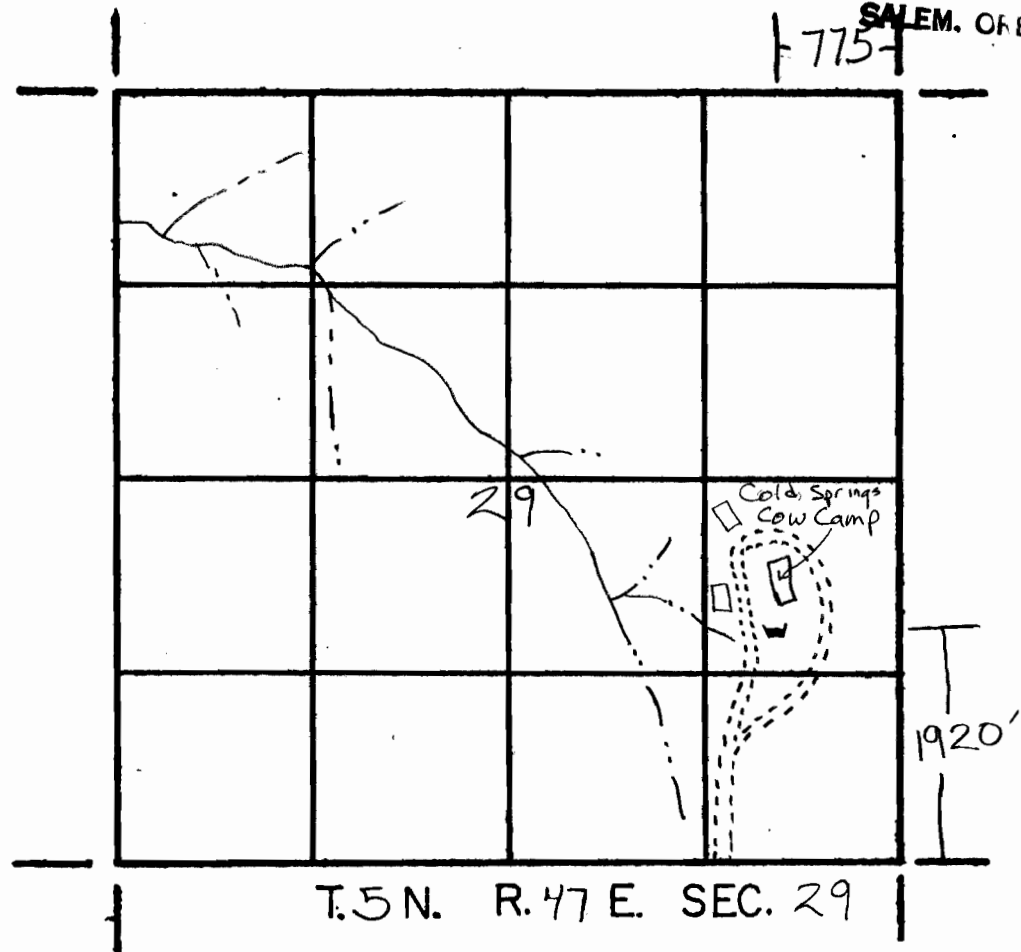

4 Inches = 1 Mile

Application No. 67593
Permit No. 49123

Prepared By Robert J. Sawyer