RECEIVED
OCT 18 1983
WATER RESOURCES DEPT.
SALEM, OREGON

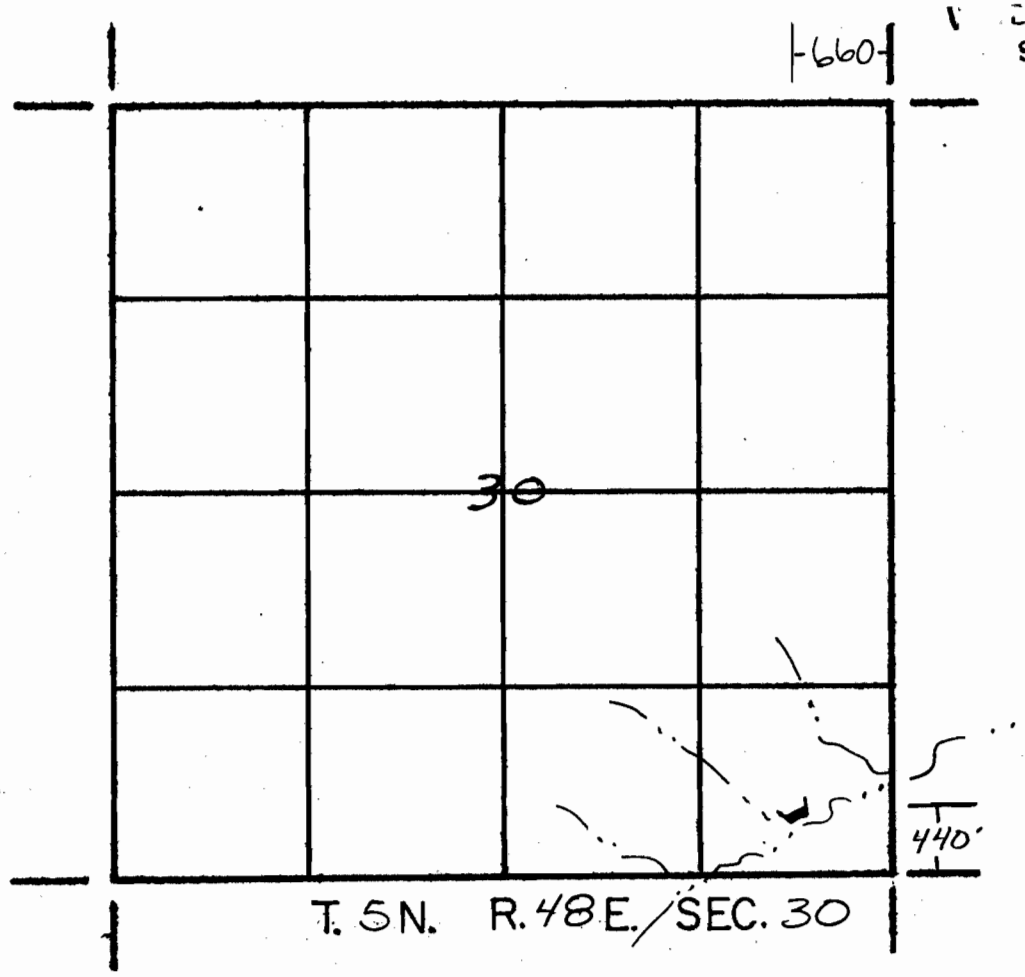

N

4 Inches = 1 Mile

Application No. 67594
Permit No. 49124

Prepared By Robert J. Barry