


RECEIVED

007161983
WATER RESOURCES DEPT
SALEM, OREGON

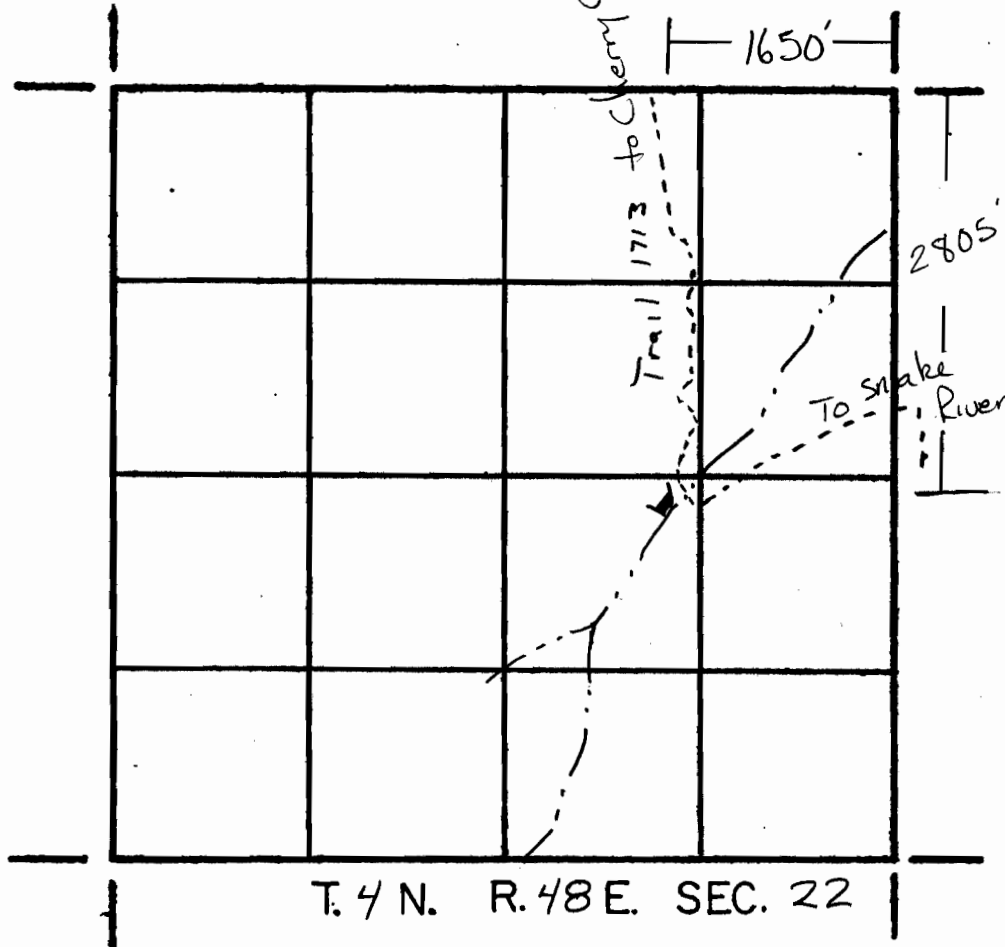

4 Inches = 1 Mile

Application No.
Permit No.

67595
49125

Prepared By Robert J. Barney