


RECEIVED

OCT 13 1983

WATER RESOURCES DEPT.
SALEM, OREGON

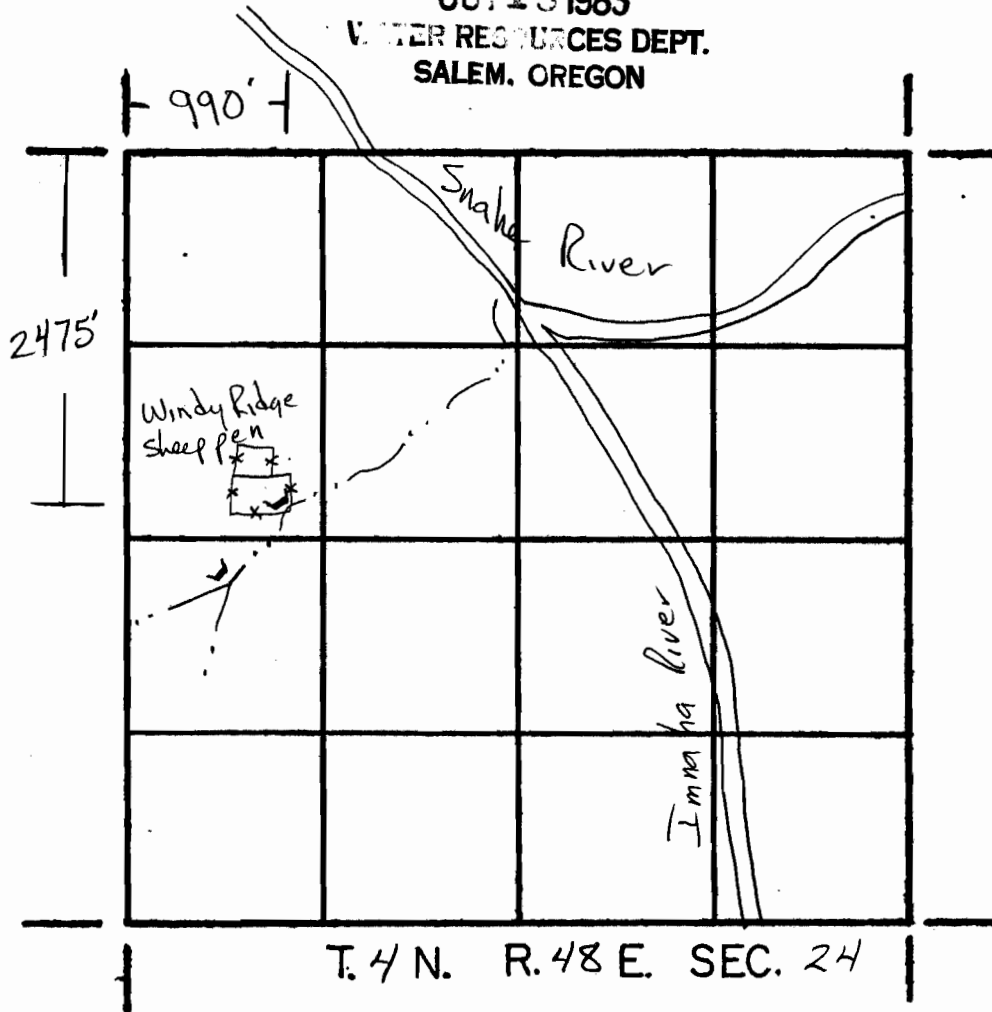

4 Inches = 1 Mile

Application No. 67596
Permit No. 49126

Prepared By Robert F. Sawyer