


T.3N.,
R.29E.,
W.M.

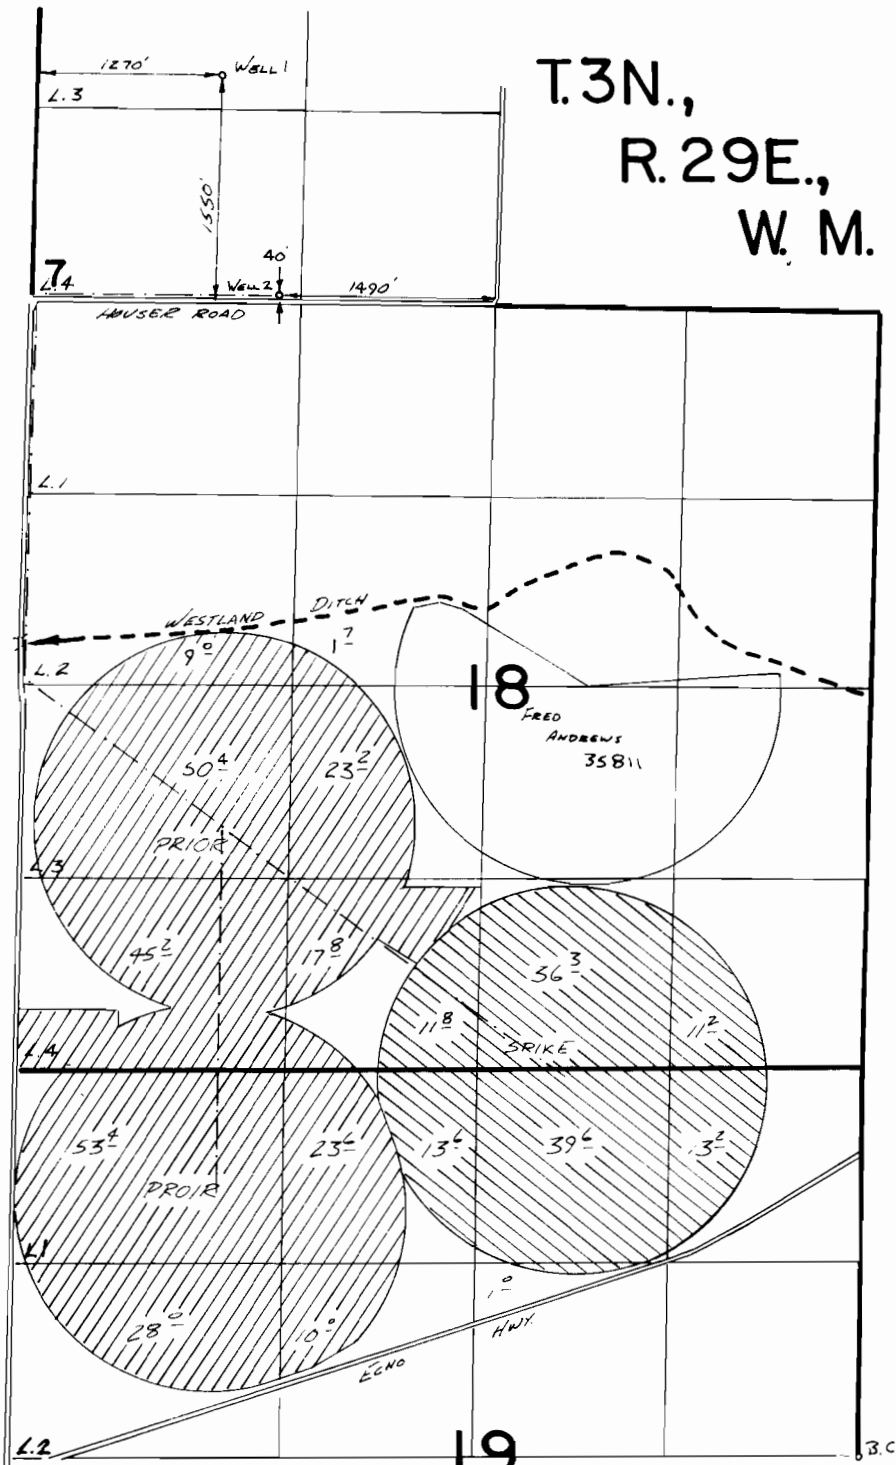

19
FINAL PROOF SURVEY
UNDER

Application No. **G:7031** Permit No. **G:6095**
IN NAME OF

TRAVELERS INSURANCE Co.

Surveyed **Feb. 16** 19**83**, by **V.L. Church**