


# T. 1 S., R. 2 & 3 W., W.M.

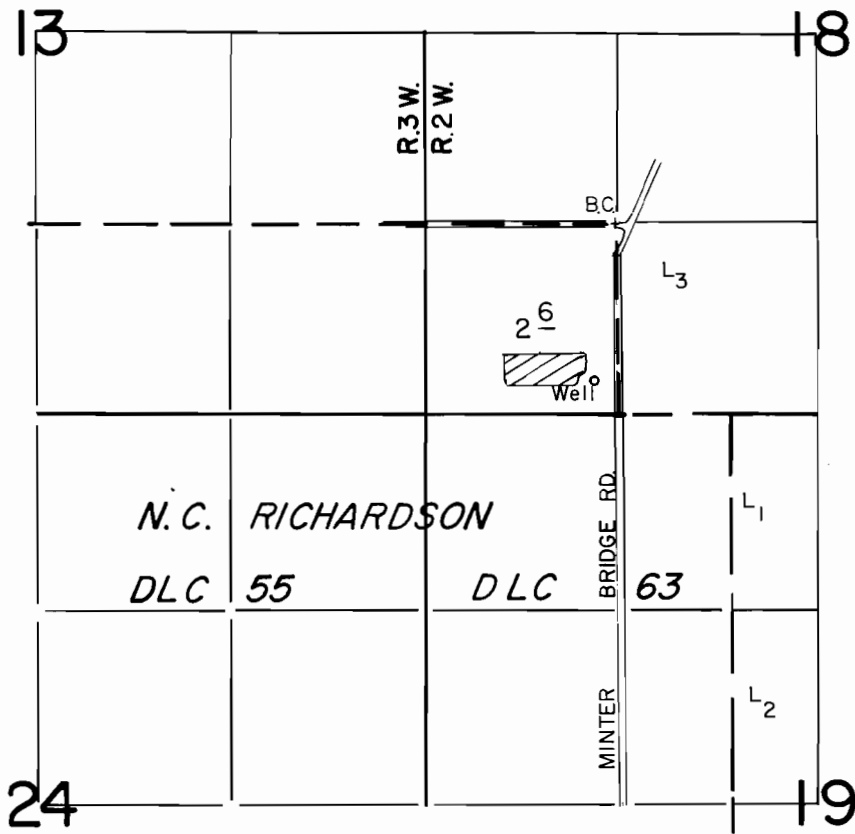

Well Loc. : 1080' S. & 160' W. from NE Cor. DLC 63.

Scale : 1" = 1320'

## FINAL PROOF SURVEY UNDER

Application No. G-7475 Permit No. G-6959  
IN NAME OF

KLAAS ELLERBROOK, JR.

Surveyed JULY 11, 1988, by T. Warren