


T. 35S., R. 33E., W.M.

Scale 1"=1320'

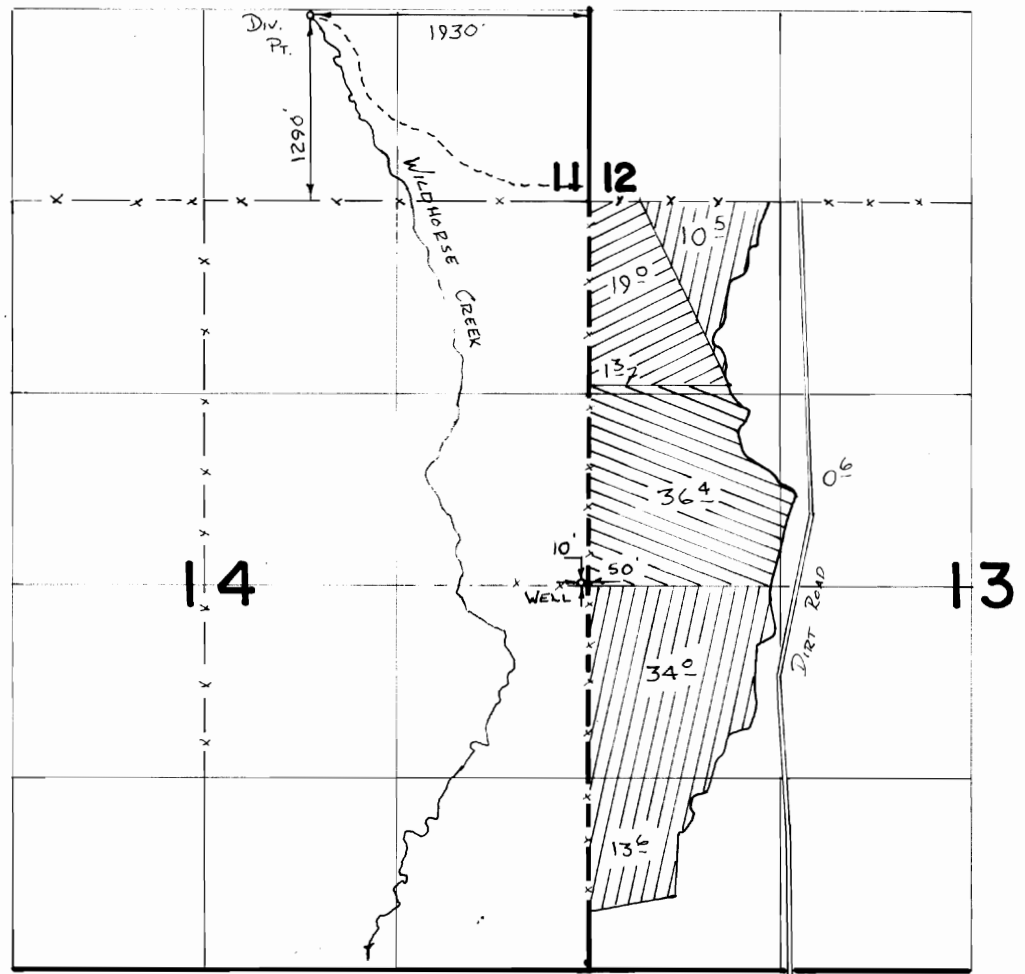

T-3985



T-4293



PER. 43216 & 44048

FINAL PROOF SURVEY
UNDER

TRANSFERS 3985, 4293

Application No. **57573** Permit No. **43216**
IN NAME OF

HENRY & BESSIE BLAIR

Surveyed 7-13-1988, by V.L. Church