


T.1&2 N. R.13 E. W.M.

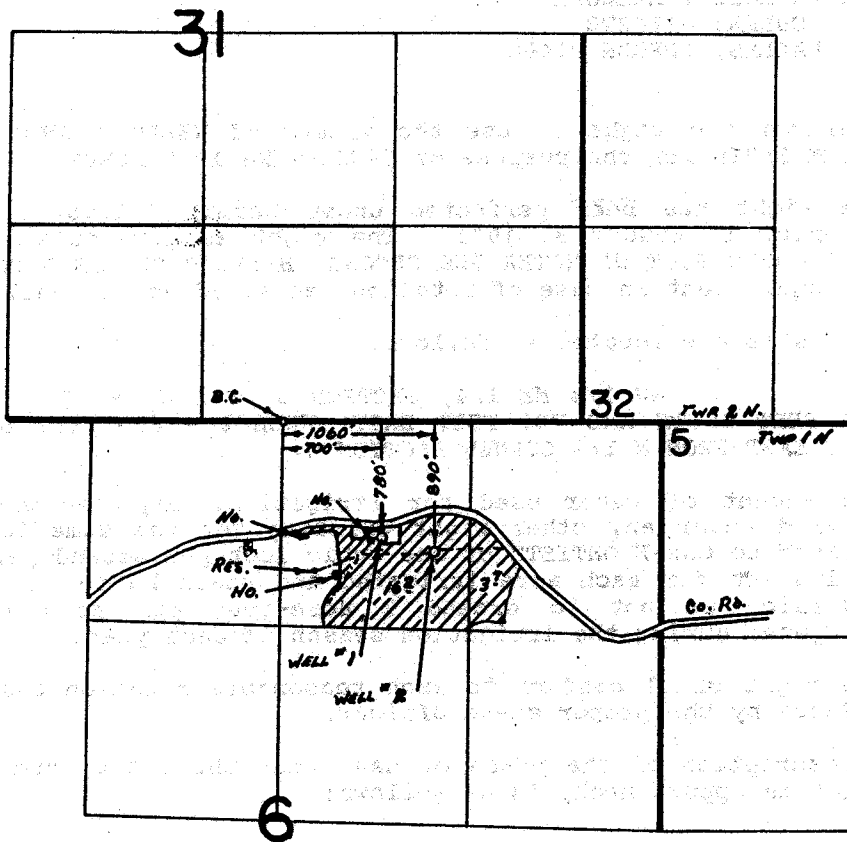

FINAL PROOF SURVEY UNDER

Application No. G-8922. Permit No. G-8396.
IN NAME OF

.....STEVEN ROBERT MALCOLM.....

Surveyed Oct. 21, 1983, by T. J. Paul.....