


T. 3S., R. 40E., W. M.

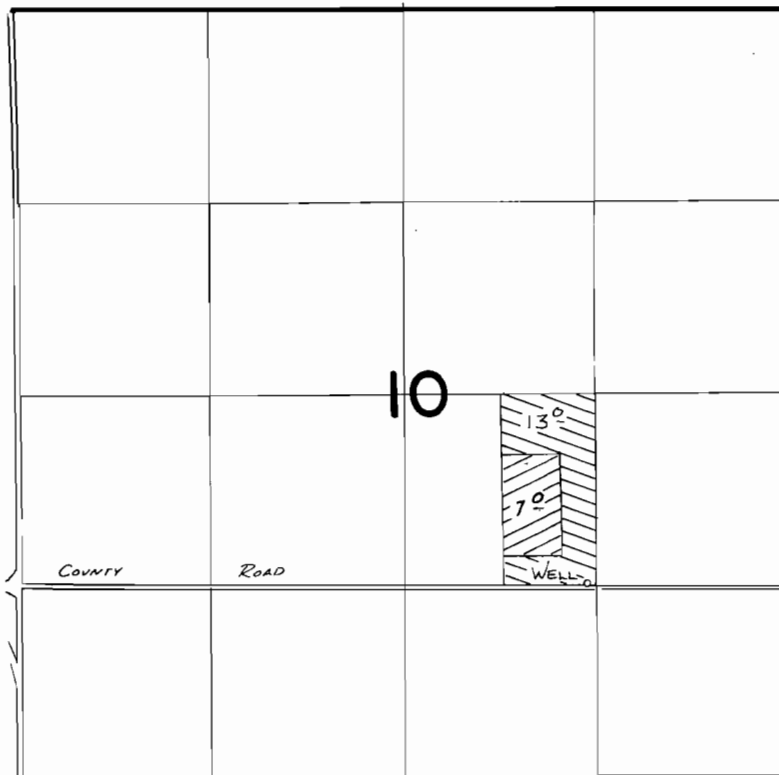

SCALE 1" = 1320'

WELL LOC: 1300'S. & 1250'E FROM CENTER COR. SECTION 10



PRIMARY



SUPPLEMENTAL

FINAL PROOF SURVEY

UNDER

Application No. **G:10025** Permit No. **G:9192**...
IN NAME OF

CHARLES L. PHINNEY

Surveyed ...7..10..... 19.84., by **V.L. Church**.....