


T.6S., R.1&2W., W.M.

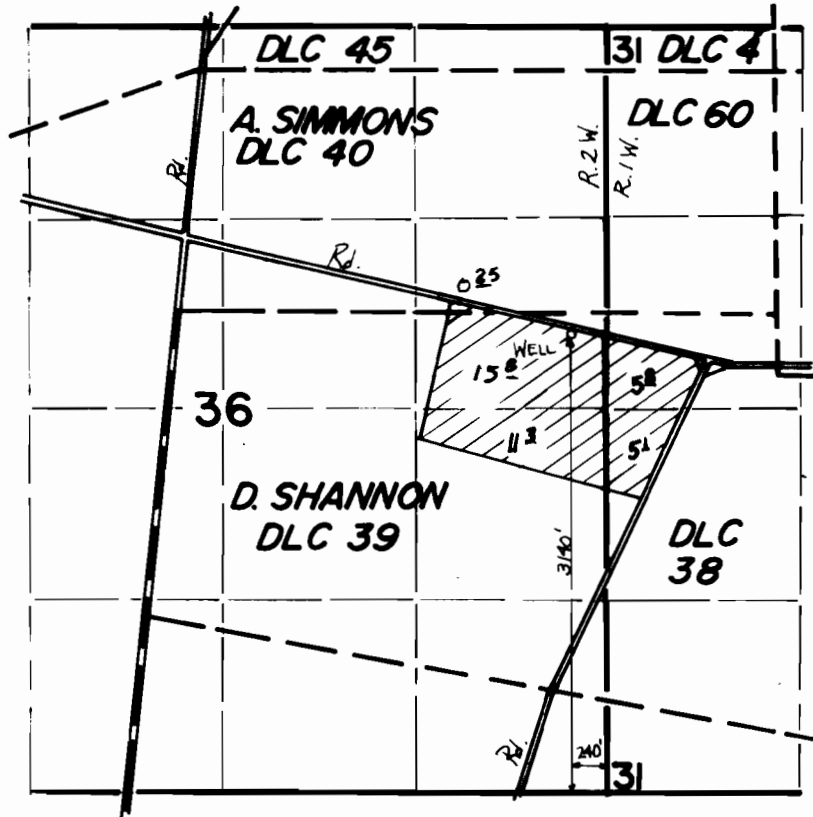

FINAL PROOF SURVEY
UNDER

Application No. G. 9612... Permit No. G. 9389.....
IN NAME OF

CLARENCE SIMMONS

Surveyed NOV. 9, 1983, by M. CAHILL.....