


T. 30 S., R. 5 W., W. M.
SECTION 17

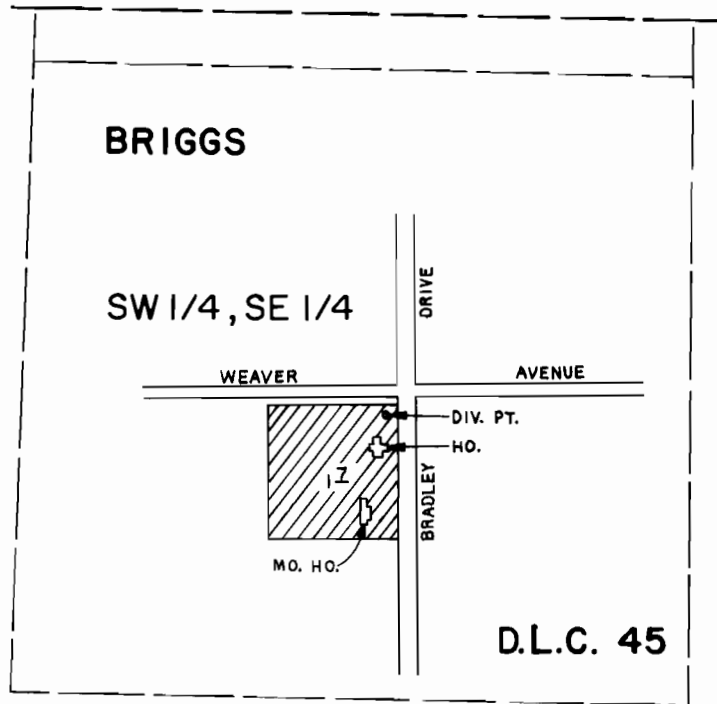

DIV. PT. LOCATED 700' S. & 640' W. FROM N.E. COR. OF THE SW 1/4, SE 1/4 SEC. 17

SCALE: 1" = 400'

FINAL PROOF SURVEY
UNDER

Application No. G-10383 Permit No. G-9479...
IN NAME OF

JOHN CLARENCE HAYTER

Surveyed JUN. 18, 1984, by L. CASHION...