



T. 2 S., R 2 W., W.M.

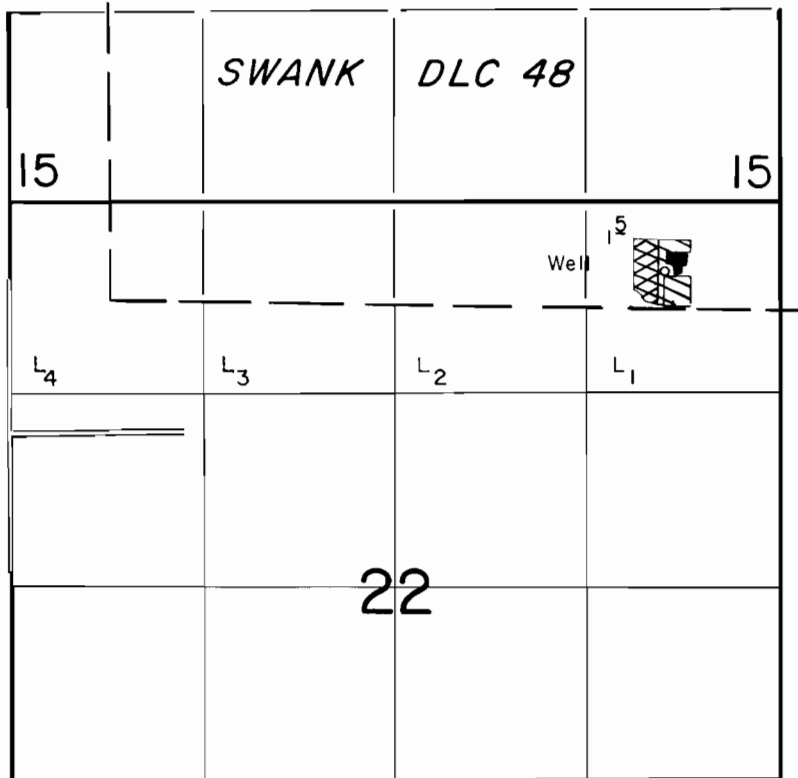

Well Loc.: 480' S. & 790' W. from NE Cor. Sec. 22.

Scale: 1" = 1320'

FINAL PROOF SURVEY
UNDER

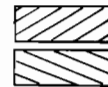

IRRIGATION

RELATED NURSERY USE

GREENHOUSE w/ CONTAINERS

Application No. G-11278.. Permit No. G-10402..
IN NAME OF

POMEROY G. SORUM

Surveyed JULY 7, 1988, by T. Warren