


# T.6S.,R.6W.,W.M.

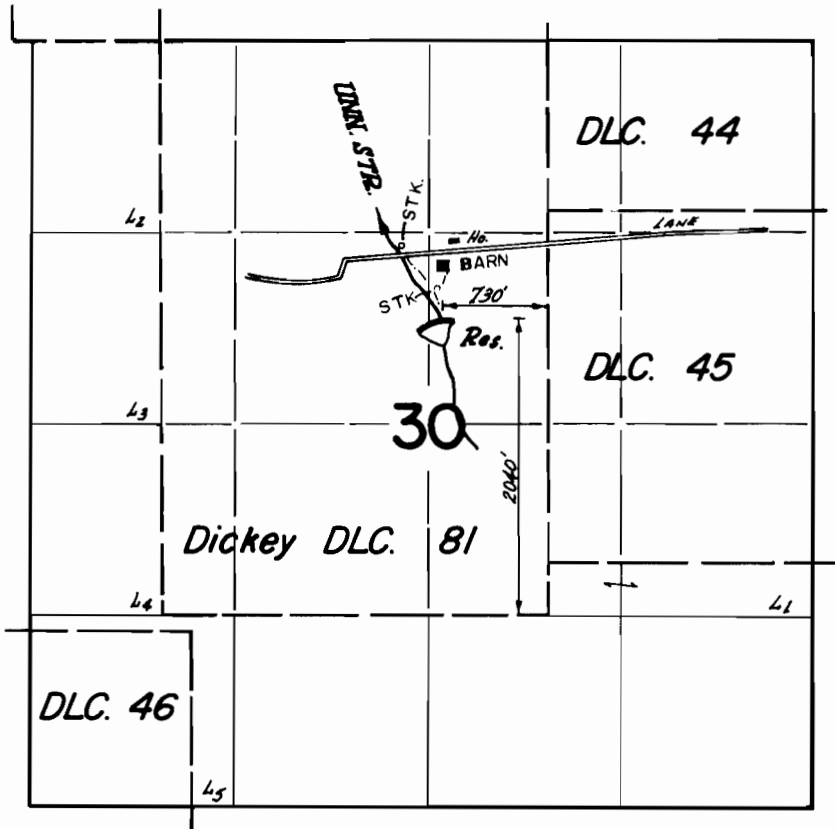

## FINAL PROOF SURVEY UNDER

57019                      42848  
Application No. R-44306 Permit No. R-5124  
IN NAME OF

R. E. OSBORN

Surveyed May 25 1972, by L.E. Gould

MAY 31, 1979

R.G. MUCKEN