


T.6S.,R.6W.,W.M.

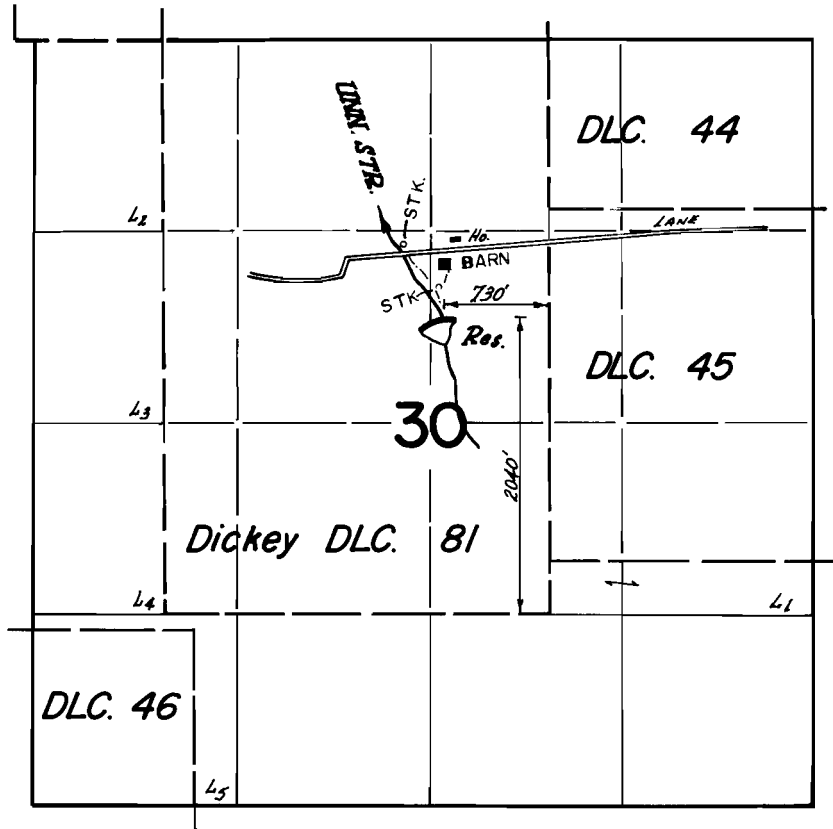

FINAL PROOF SURVEY
UNDER

57019 42848
Application No. ~~R-44306~~ Permit No. ~~R-5124~~
IN NAME OF

R. E. OSBORN

Surveyed *May 25* 19*72*, by *L.E. Gould*

MAY 31, 1979 R.G. MUCKEN