


T.17S., R.1W., W.M.

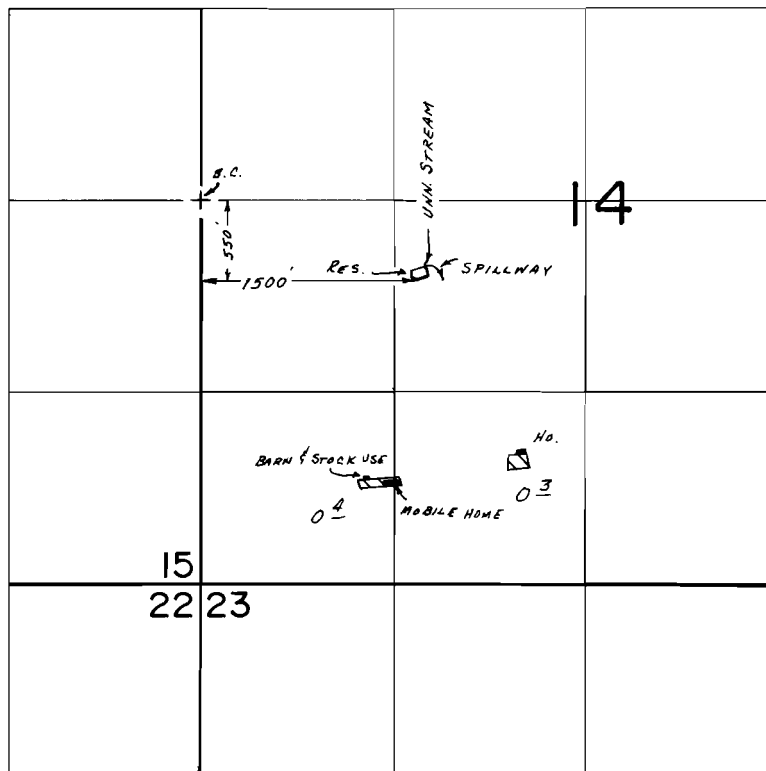

FINAL PROOF SURVEY
UNDER

R-56952 R-7020
Application No. 56953 Permit No. 42842.....
IN NAME OF

.....CARROL FOUNTAIN.....

Surveyed Sept. 16, 1983, by L.M. TOLL.....