


T. 3 S, R. 3 W, W.M.

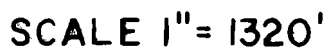

DIV. POINT: 950' N & 1450' W FROM SE CORNER SEC. 3

FINAL PROOF SURVEY

UNDER

R-57669

R-7666

Application No. **57670**..... Permit No. **43291**.....
IN NAME OF

SILVIO CARBONE

Surveyed **SEP. 26 1988**, by **Z. SALEH**

41071-178-134L
12-12-1988 Z.F.S.