


T. 3 S, R. 3 W, W.M.

SCALE 1" = 1320'

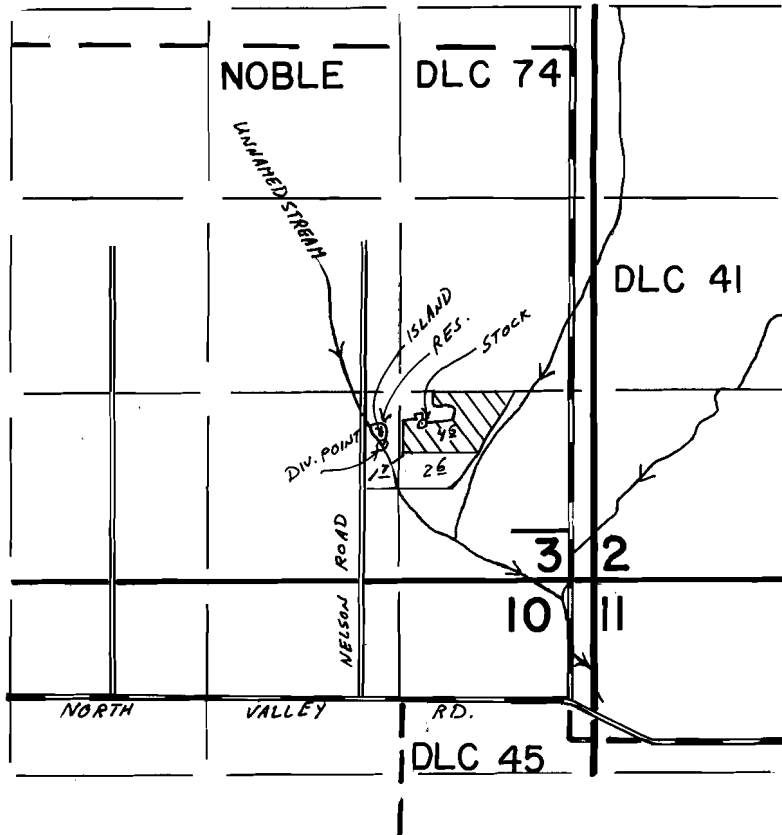

DIV. POINT: 950' N & 1450' W FROM SE CORNER SEC. 3

FINAL PROOF SURVEY
UNDER

R-57669

R-7666

Application No. 57670..... Permit No. 43291.....
IN NAME OF

SILVIO CARBONE

Surveyed SEP. 26 1988, by Z. SALEH