




T. 27 S., R. 11 W., W.M.

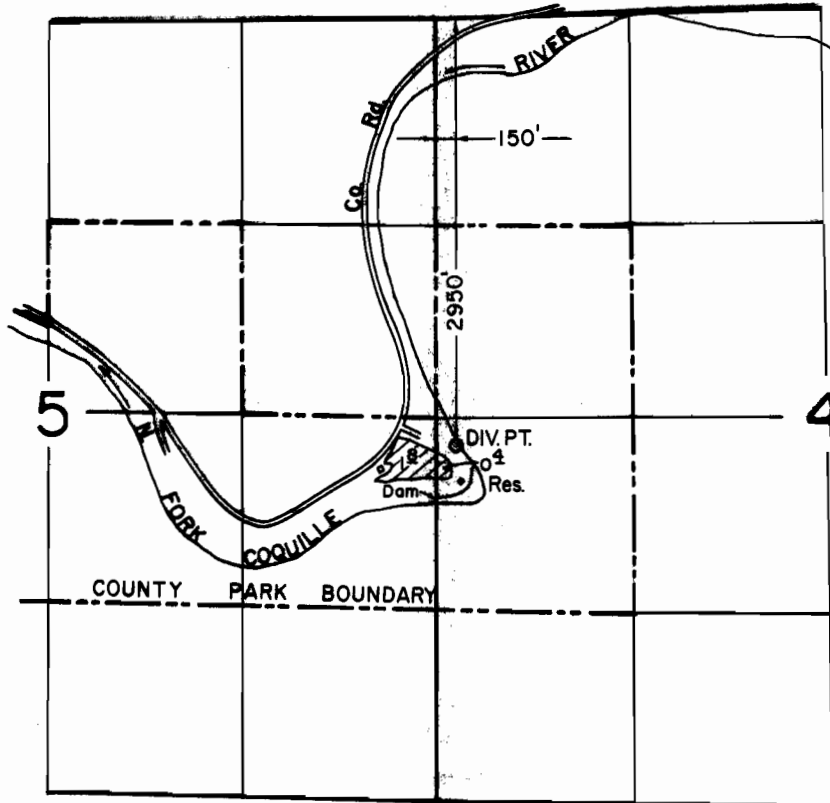

DAM LOC.: 3320'S. & 10'E. FROM THE NW CORNER SECTION 4

SCALE: 1" = 1320'

**FINAL PROOF SURVEY**  
UNDER

R-57241                      R-7703

Application No. 57242. Permit No. 43497.....

IN NAME OF

..... COOS COUNTY .....

Surveyed SEPT. 19. 1988., by Z. SALEH.....