


T.23S., R.5W., W.M.

SECTION 21

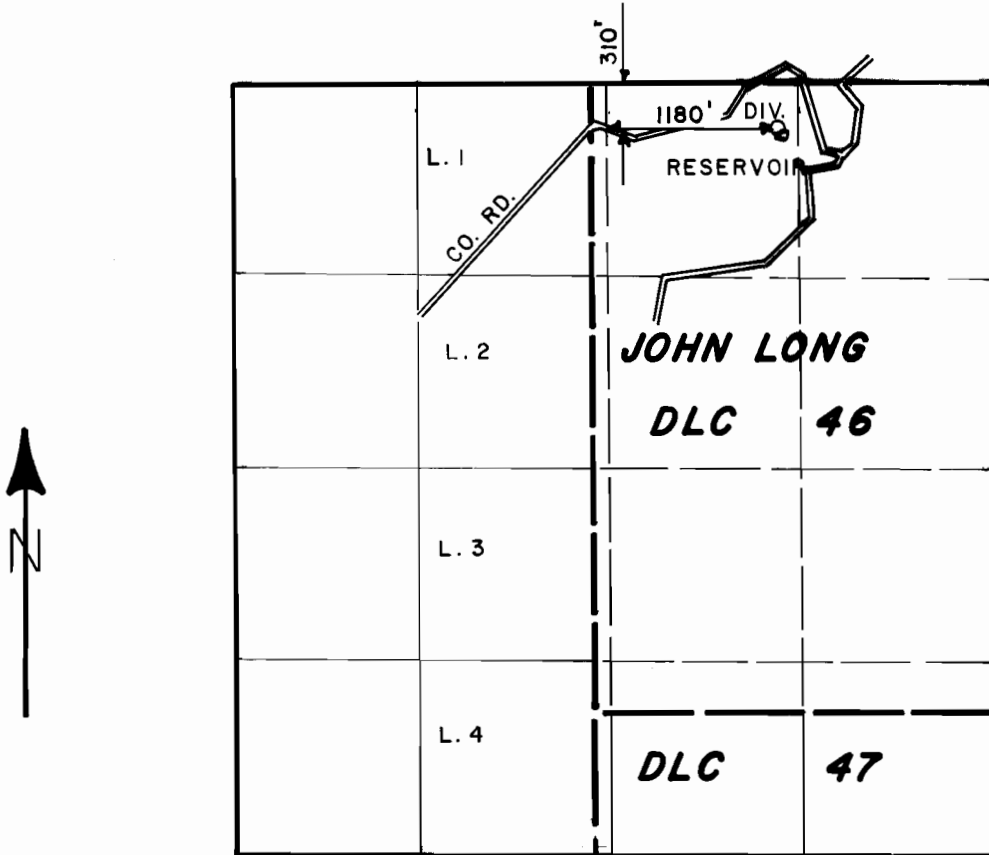

SCALE: 4" = 1 MILE

FINAL PROOF SURVEY
UNDER

Application No. R-63500 Permit No. R-8456...
IN NAME OF

DANE F. CLARK

Surveyed AUG. 16, 1988, by J.M. SCHMORDE.