


T. 3S., R. 37E. W.M. SEC. 24

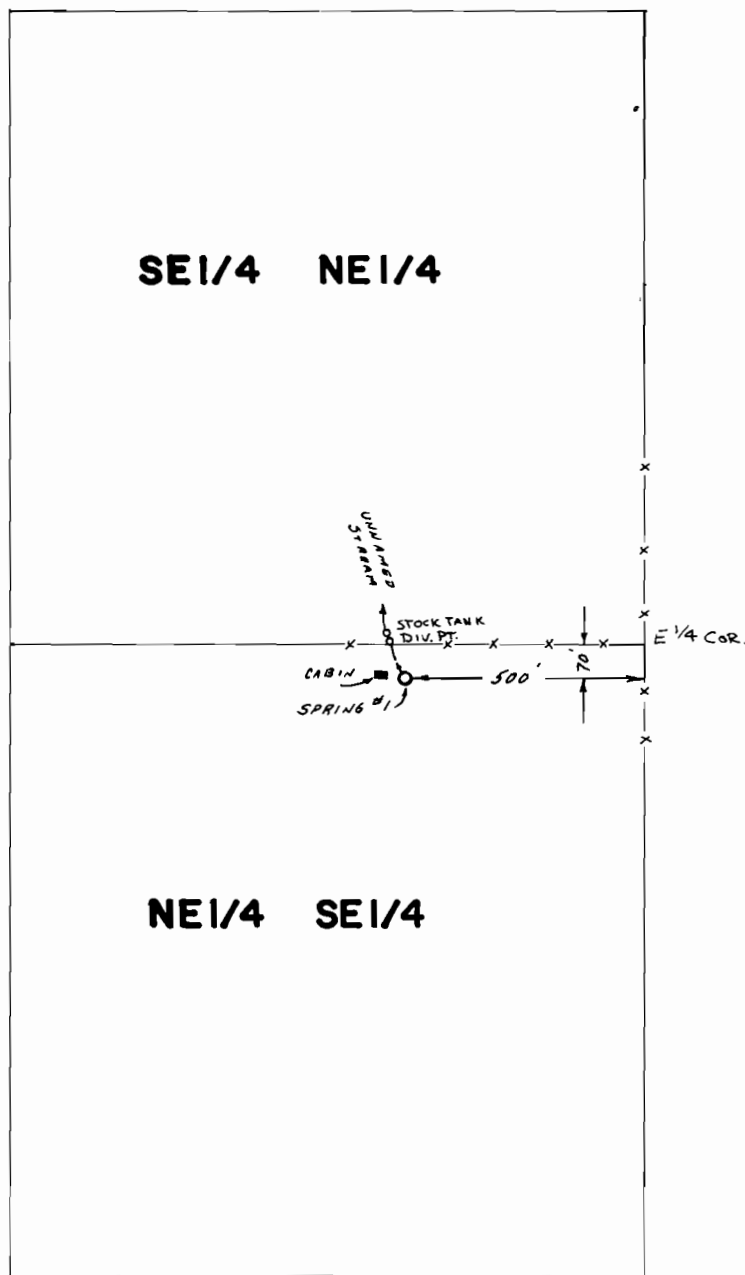

SCALE 1" = 400'

Div. Pt. loc: 530' W. From E 1/4 COR. SECTION. 24

FINAL PROOF SURVEY
UNDERApplication No. **48930** Permit No. **36618**.....
IN NAME OF**JOHN H. & LORETTA L. BEESON, STUART F. & CECILIA C. WYLDE**

Surveyed SEPT...7.... 1988, by V. L. Church.....