


# T. 41 S., R. 12 W., W.M.

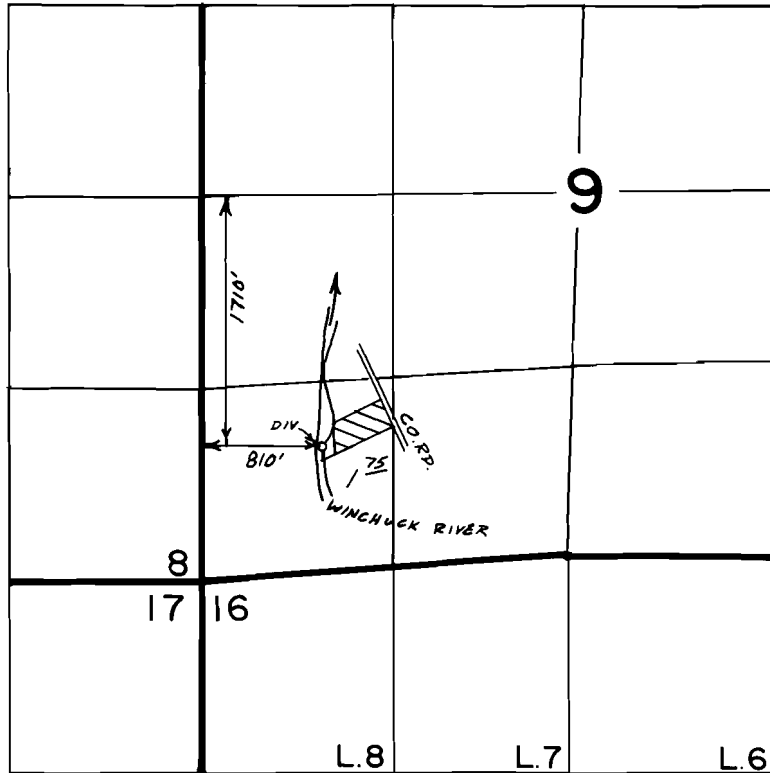

Scale 1" = 1320'

## FINAL PROOF SURVEY UNDER

Application No. 530.45. Permit No. 37.831.....  
IN NAME OF

WILLIAM R. & BETTY L. CROOKS

Surveyed Oct. 7..... 19.8.8, by B.S. JAMES.....