



38360
61563

T. 28S., R. 14E., W.M.

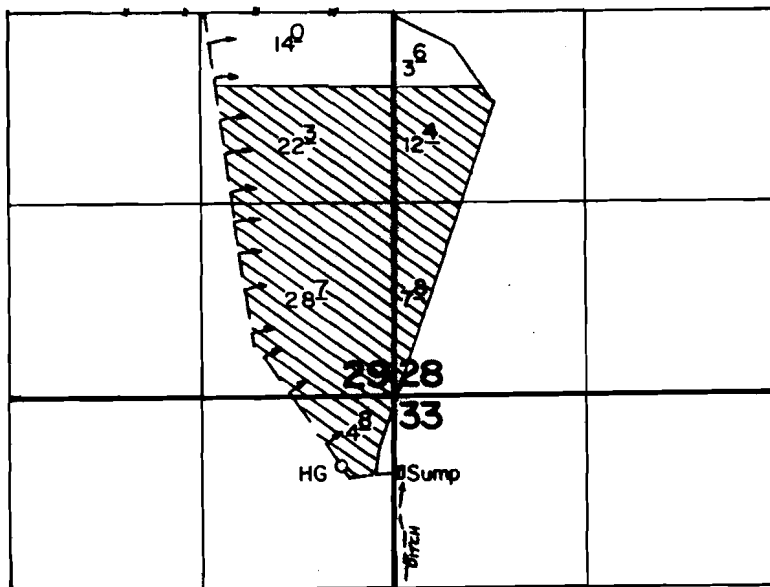

Scale: 1" = 1320'

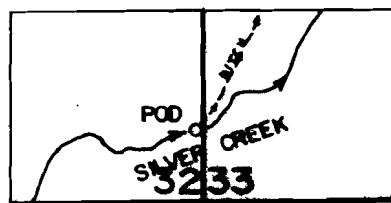

POD LOC.: 500' N. & 50' W. from SE Cor. Sec. 32.

FINAL PROOF SURVEY
UNDER

Application No. 50801..... Permit No. 38360.....
IN NAME OF

EMERY LIVESTOCK COMPANY

Surveyed Sept. 15, 1985, by J. Warren.....