


T. 35 S., R. 4 W., W. M.

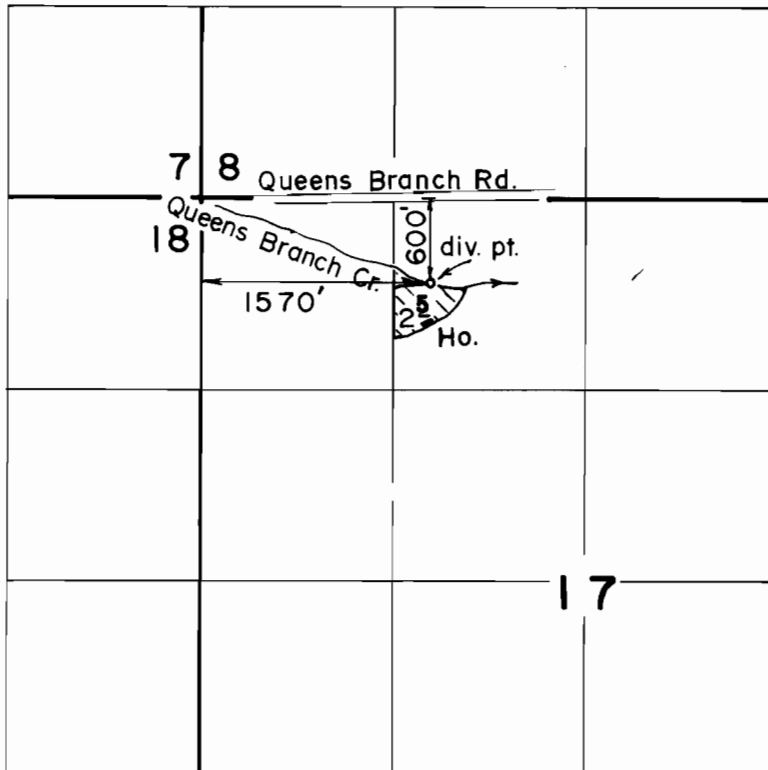

Scale: 1" = 1320'

FINAL PROOF SURVEY
UNDER

Application No. 51056 Permit No. 38527...
IN NAME OF

GLEN L. & ESTELLE ALLEN

Surveyed JUN. 25. 1987, by B. S. JAMES...