


T. 41 S., R. 8 W., W.M.

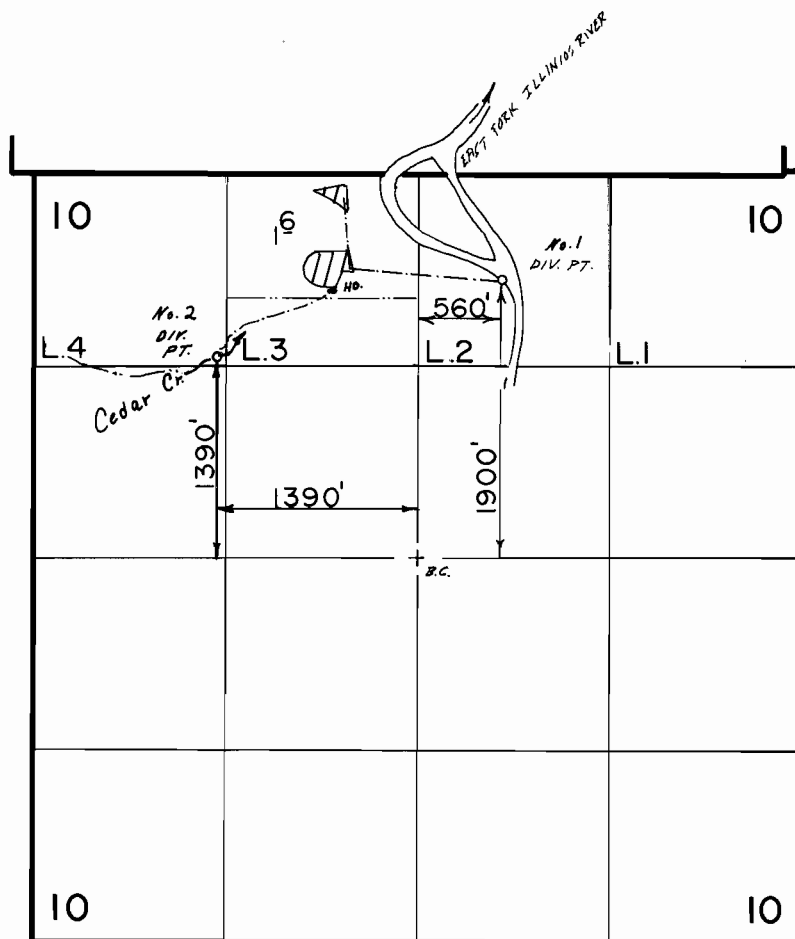

N

Scale 1"=1320'

FINAL PROOF SURVEY

UNDER

Application No. 54164.. Permit No. 40548.....
IN NAME OF

Mr. & Mrs. EDWARD REED.....

Surveyed April 24, 1986., by BS JAMES.....