


T.15S. R.5W. W.M.

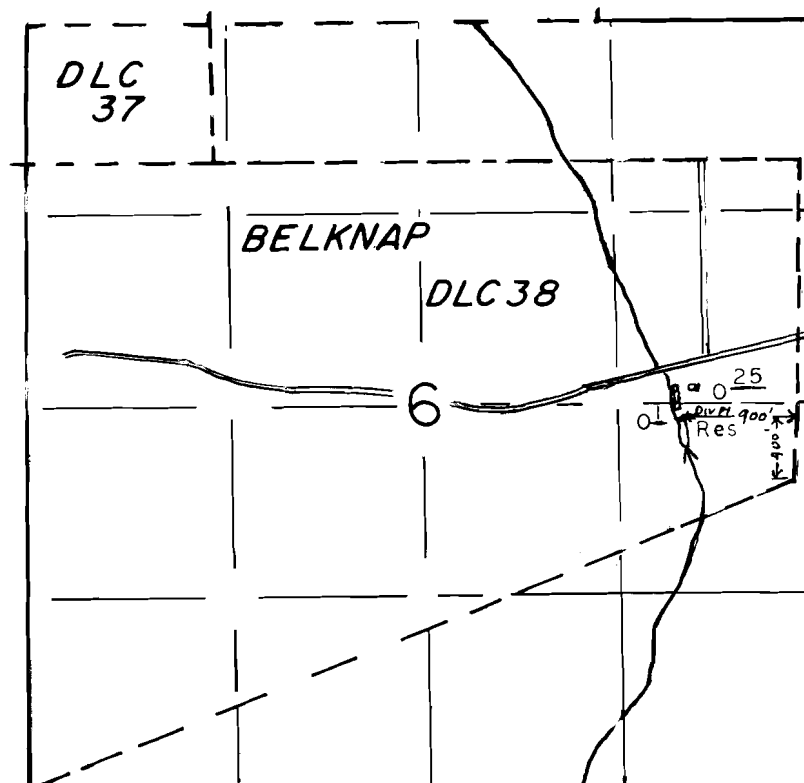

N

SCALE: 1"=1320'

FINAL PROOF SURVEY UNDER

Application No. **54408** Permit No. **40801**.....
IN NAME OF

.....**CORNELIUS & NAOMI**.....**ELSPAS**.....

Surveyed **OCT 27, 1987**, by **TM WARREN**.....