


T.6 N., R.5 W., W.M.

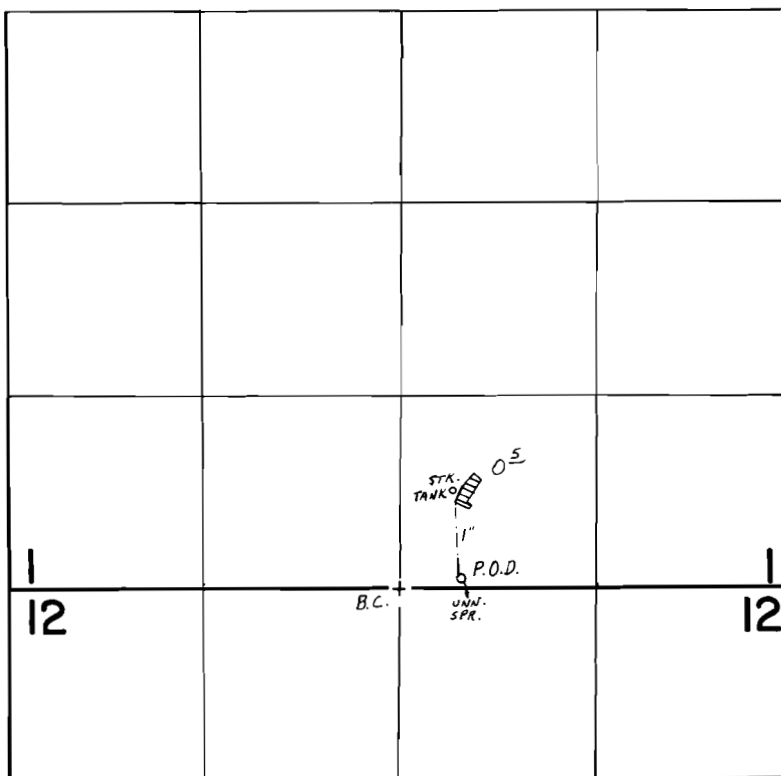

P.O.D. Loc. : 70' N. & 420' E. from S 1/4 Cor. Sec. 1.

Scale : 1" = 1320'

FINAL PROOF SURVEY UNDER

Application No. 54585 Permit No. 40959

IN NAME OF

CADENZA CORPORATION

Surveyed AUG. 13. 1986, by T. Warren

PTS-1986-C
TMW 1/12/87