


T. 41 S., R. 12 W., W. M.

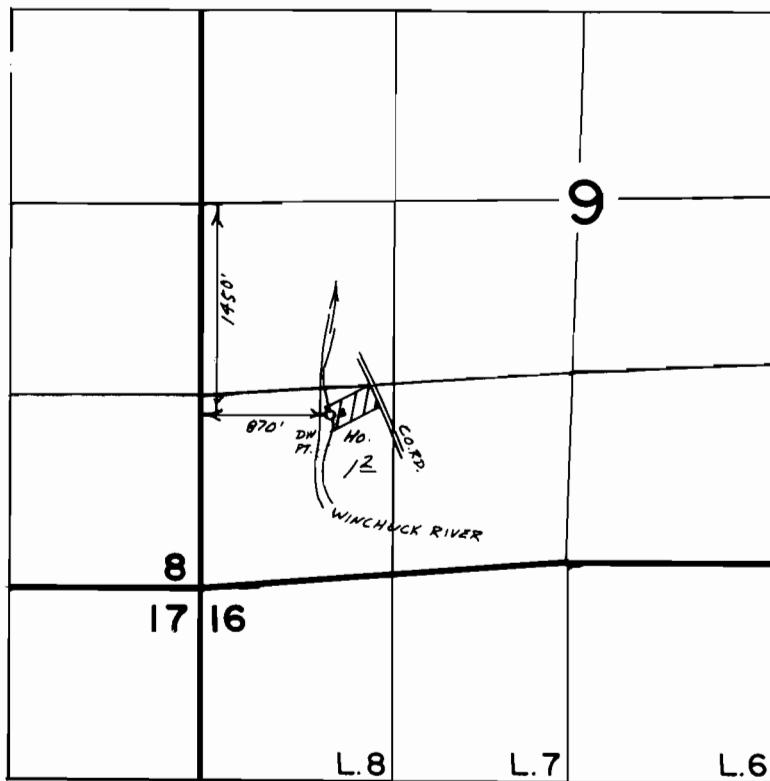

Scale 1" = 1320'

FINAL PROOF SURVEY
UNDER

Application No. 54738. Permit No. 41061.....
IN NAME OF

...C.R. 8... HARRIET... L... DRAPER.

Surveyed Oct... 7... 1988, by B.S. JAMES.....