


T. 22 S., R. 5 W., W. M.

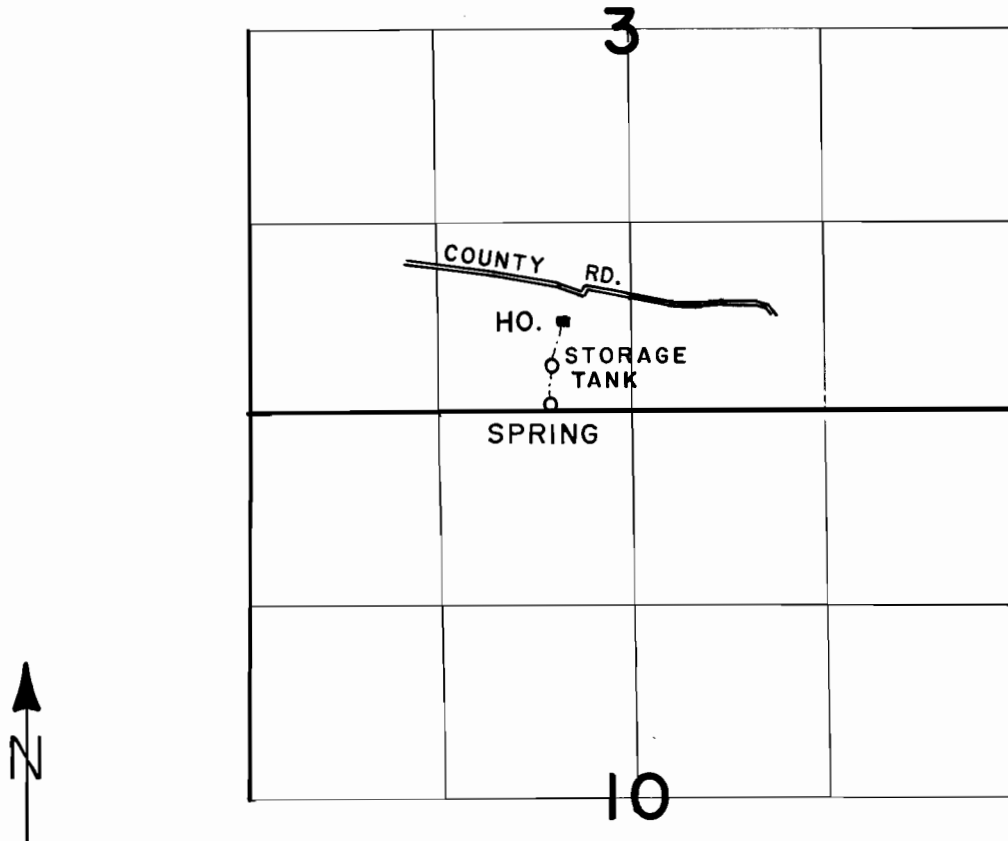

SPRING LOCATED 50' N. & 2050' E. FROM SW. CORNER SECTION 3.

SCALE: 4" = 1 MILE

FINAL PROOF SURVEY

UNDER

Application No. 55057 Permit No. 41291
IN NAME OF

JOHN D. & LAURA F. LAKEY

Surveyed NOV. 9 1987, by J. M. SCHMORDE