


# T.32 S., R.1 E., W.M.

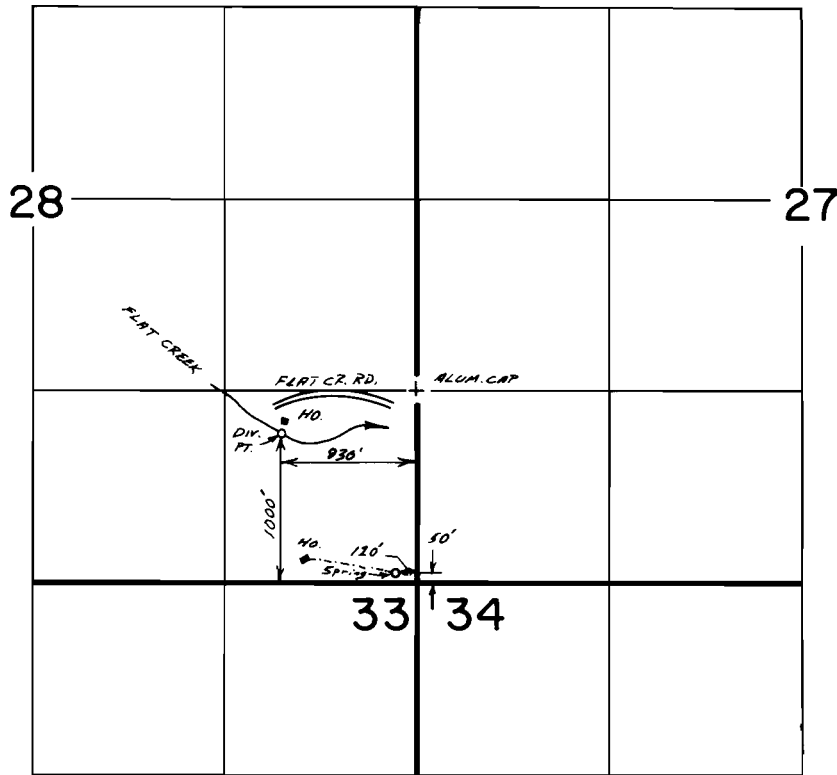

SCALE : 1" = 1320'

## FINAL PROOF SURVEY UNDER

Application No. 55666 Permit No. 41700  
IN NAME OF

JACK M. & JUDITH L. VAUGHAN

Surveyed August 27, 1987, by B.S. JAMES