


T. 35 S., R. 7 W., W.M.

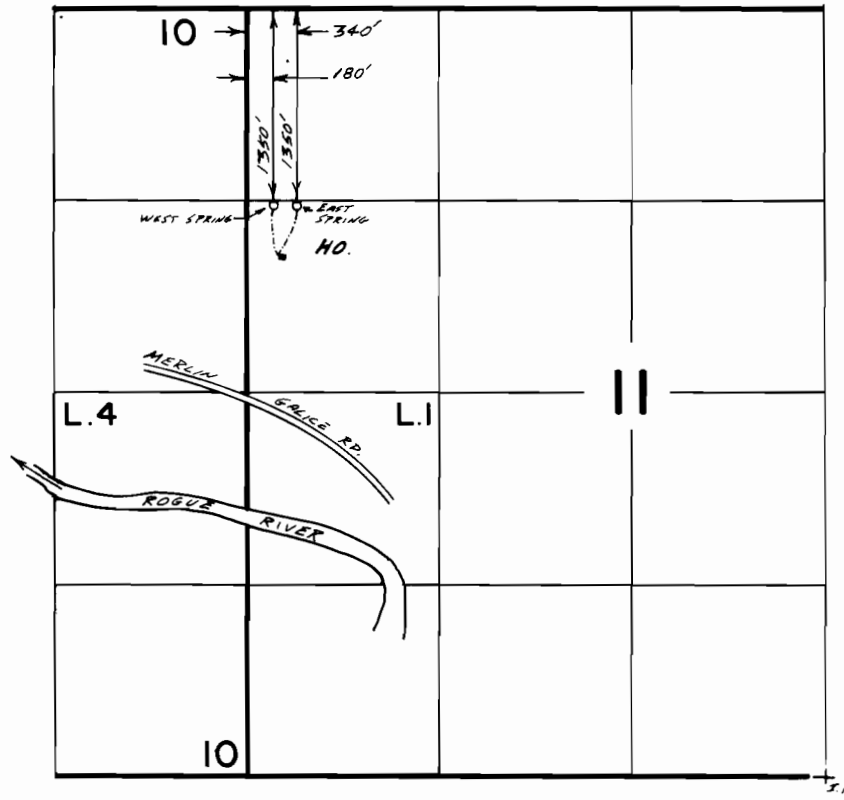

Scale 1" = 1320'

FINAL PROOF SURVEY UNDER

Application No. 55895 Permit No. 41923

IN NAME OF

LOUIS W ERCK

Surveyed Oct. 28, 1987, by B.S. JAMES