


T.8S., R.38E., W.M.

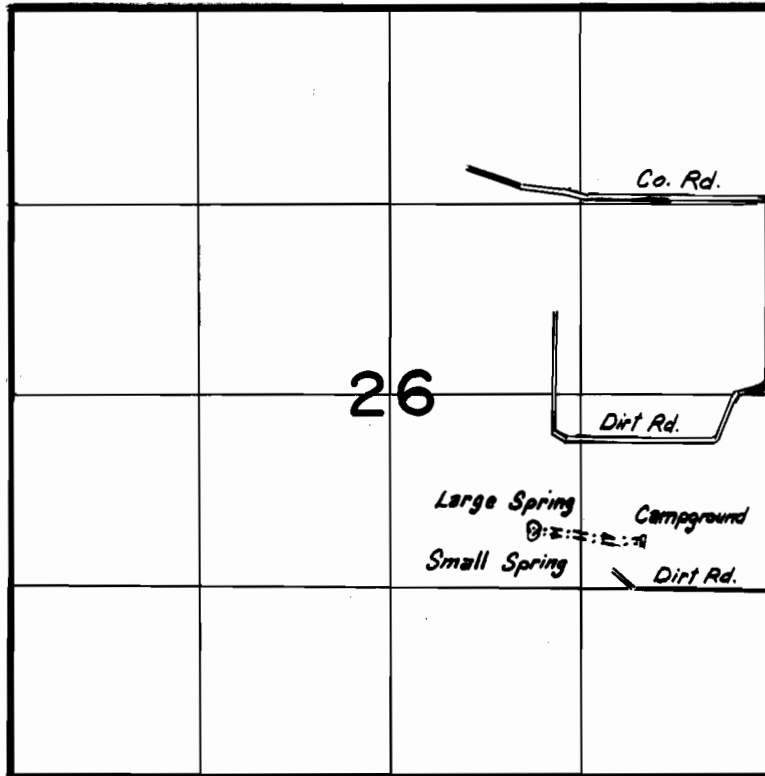

*The location of large spring is 1690' N. & 1670' W. ,  
small spring is 1660' N. & 1650' W.; both from  
SE cor. sec. 26.*

**FINAL PROOF SURVEY**  
UNDER

  
Scale: 1" = 1320'

Application No. 56300 Permit No. 42341  
IN NAME OF

DELANO ARTHUR DICKEY

Surveyed 10-1 1987, by Vern Church

41001-179-281R KK