


T. 41 S., R. 13 W., W.M.

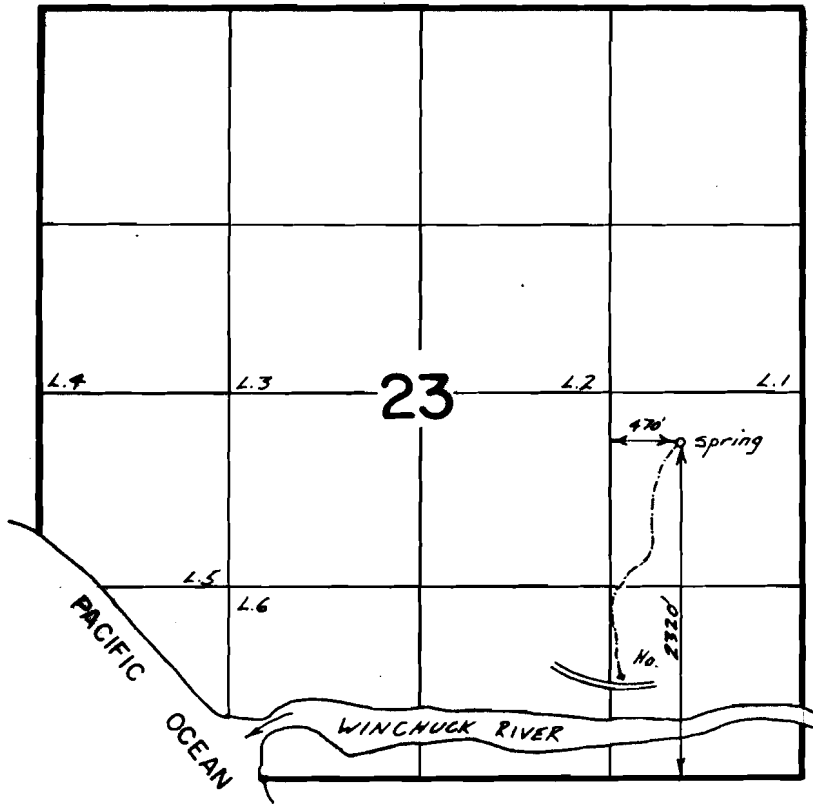

Scale 1" = 1320'

**FINAL PROOF SURVEY**  
UNDER

Application No. 56269.. Permit No. 42370.....  
IN NAME OF

.....**WALTER SCOTT**.....

Surveyed Aug. 14, 1979., by J.S. DONALDSON  
Oct. 1, 1987, by B.S. JAMES