


T.37S., R.9 W., W.M.

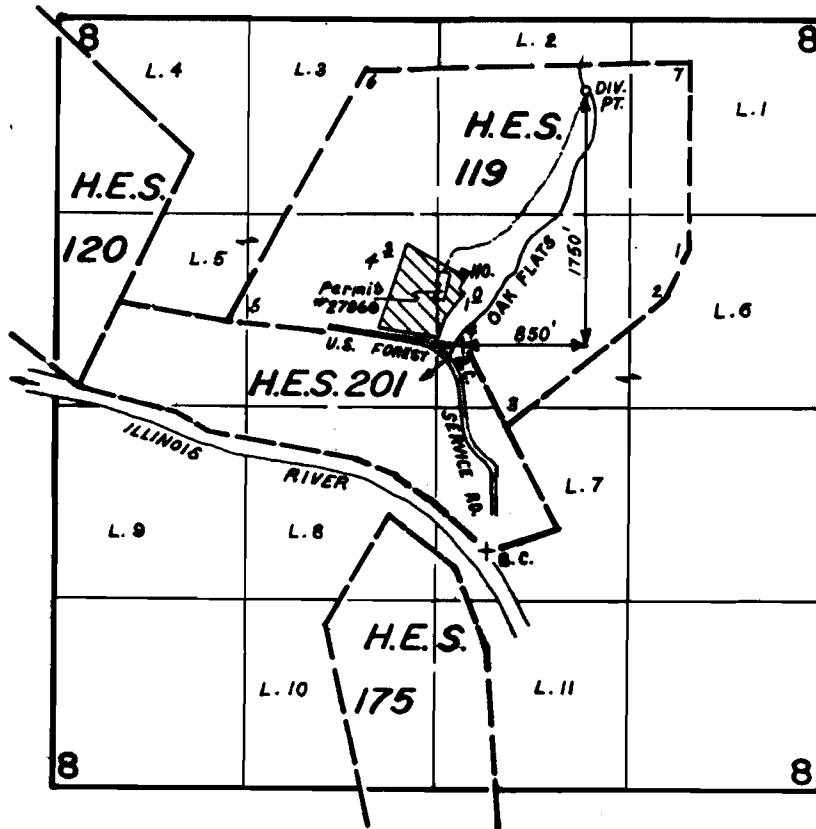

SCALE: 1" = 1320'

FINAL PROOF SURVEY UNDER

Application No. 56938 Permit No. 42807
IN NAME OF

JERRY SORENSEN

Surveyed MAR. 2 1984, by B.S. JAMES