




T. 26 S., R. 11 W., W.M.

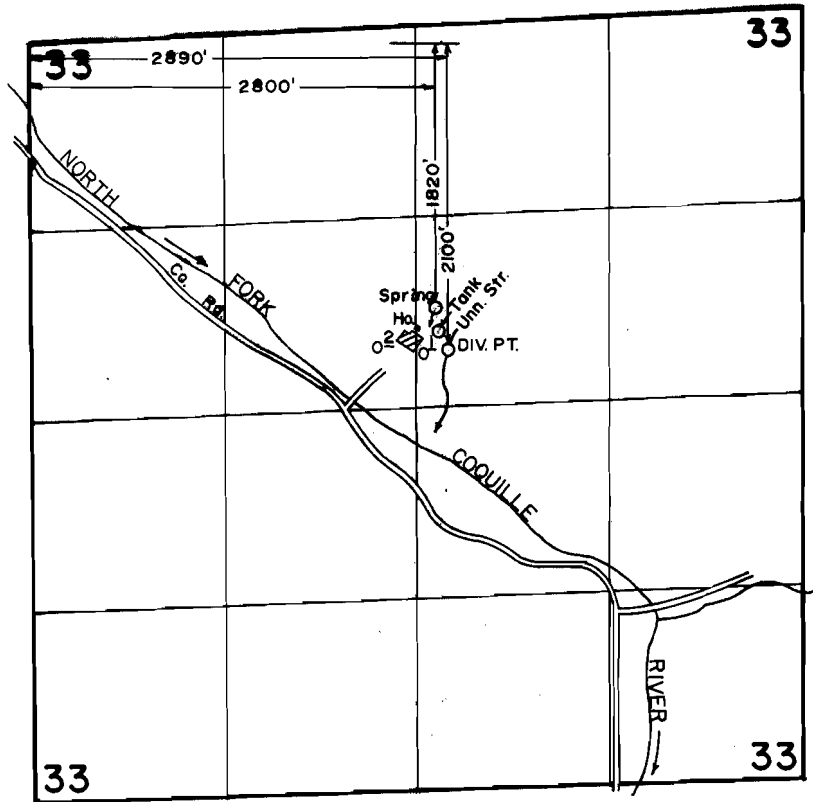

SCALE: 1" = 1320'

**FINAL PROOF SURVEY**  
UNDER

Application No. 56663 Permit No. 42824  
IN NAME OF

DAVID WAYNE & DEBRA LARAE REASOR

Surveyed SEPT. 21, 1988, by Z. SALEH