


T19S. R37E. WM.

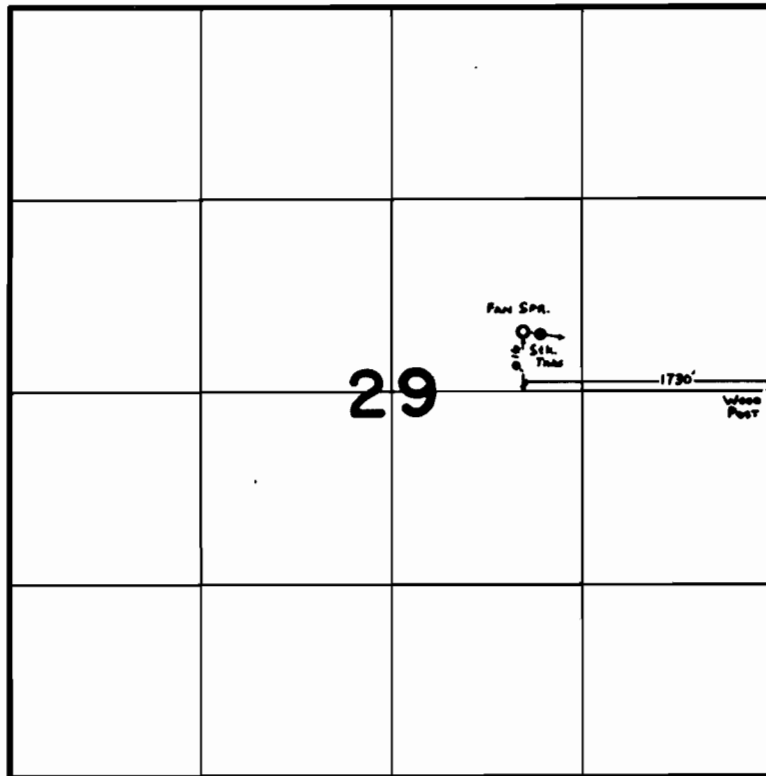

FINAL PROOF SURVEY
UNDER

Application No. 56717 Permit No. 42871
IN NAME OF

BUREAU OF LAND MANAGEMENT

Surveyed Sept. 21, 1979, by C. L. HUGHES