


# T3N, RIOW, WM

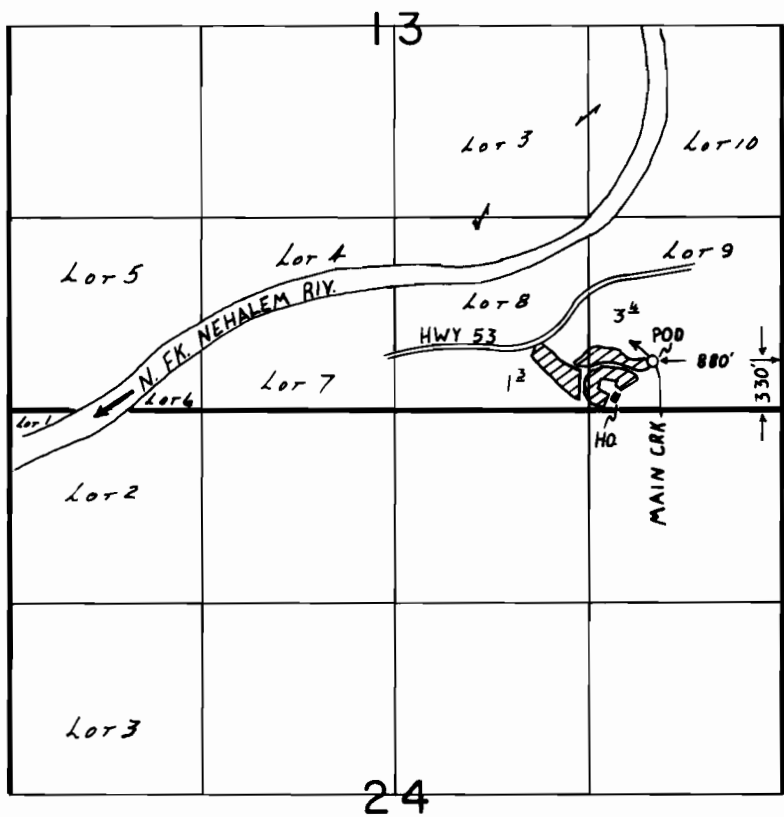

## FINAL PROOF SURVEY UNDER

Application No. 56667. Permit No. 42981.....  
IN NAME OF

CAROLYN M. COLEMAN.....

Surveyed JULY 6 1987., by J.M. WARREN...