


T.35S., R.1W., W.M.

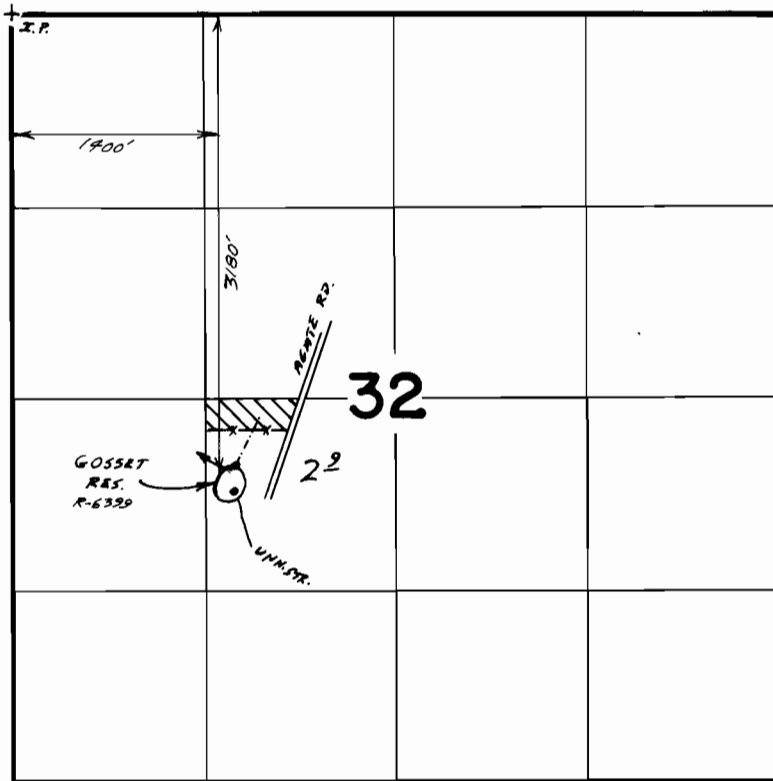

Scale 1" = 1320'

FINAL PROOF SURVEY UNDER

Application No. 57449 Permit No. 43275
IN NAME OF

WAYNE DEBRICK

Surveyed May 21, 1987, by B.S. JAMES