


90684

T. 36 S., R. 8 W., W. M.

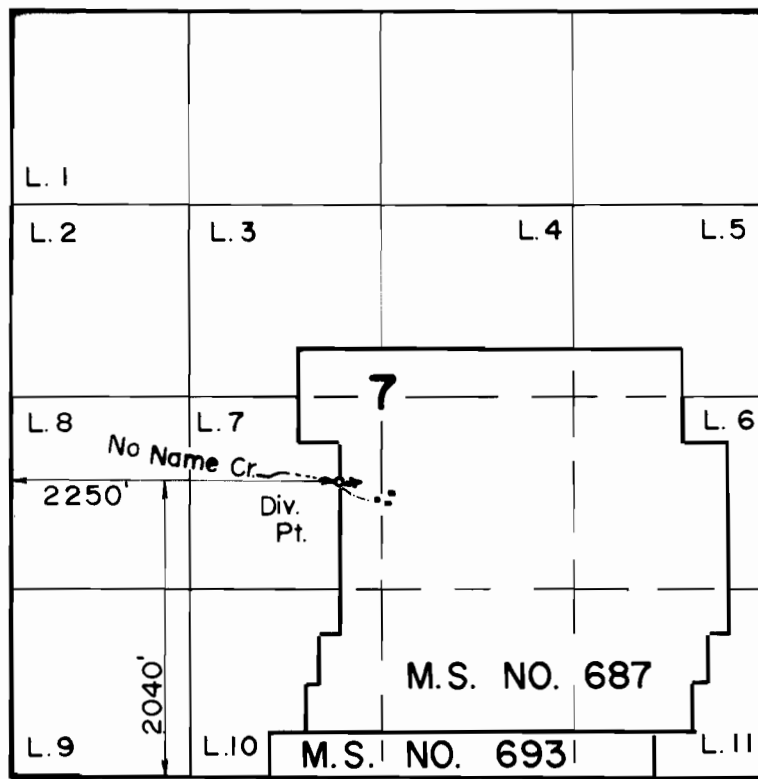

Scale: 1" = 1320'

FINAL PROOF SURVEY
UNDER

Application No. **57666** Permit No. **43429**
IN NAME OF

GEORGE W. REYNOLDS

Surveyed **OCT. 29, 1987**, by **B. S. JAMES**