


T.9S., R.45E., W.M.

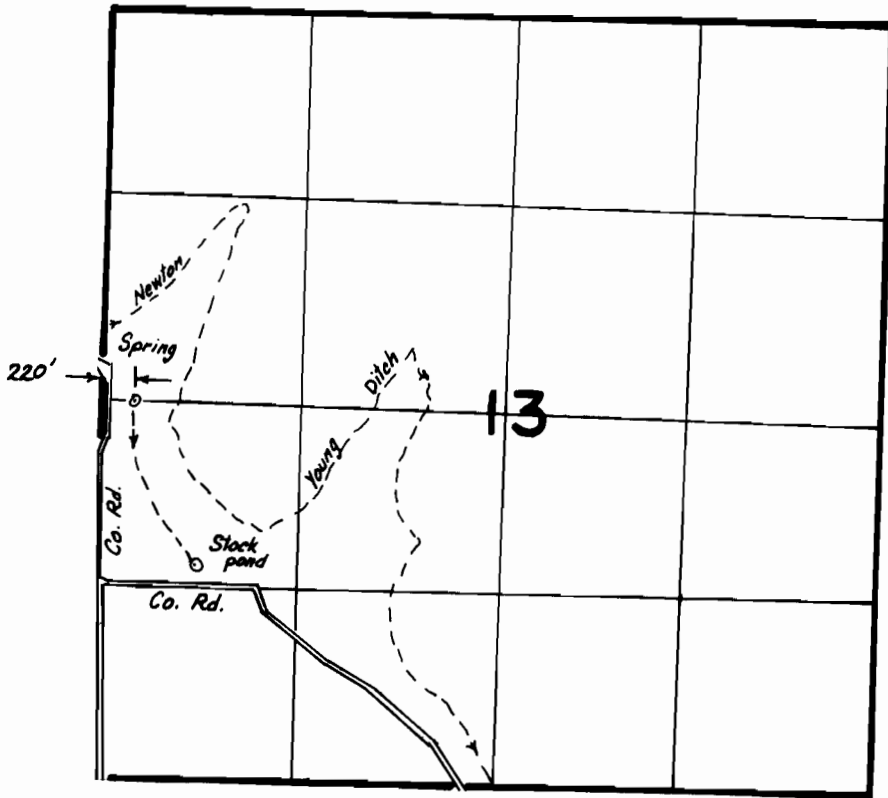

Scale: 1" = 1320'

FINAL PROOF SURVEY UNDER

Application No. 58021... Permit No. 43728...
IN NAME OF

WALTER E. & GERALDINE M. GRAVEN

Surveyed 10-5 1988, by Kenn Kemp