


T. 41 S., R. 13 W., W.M.

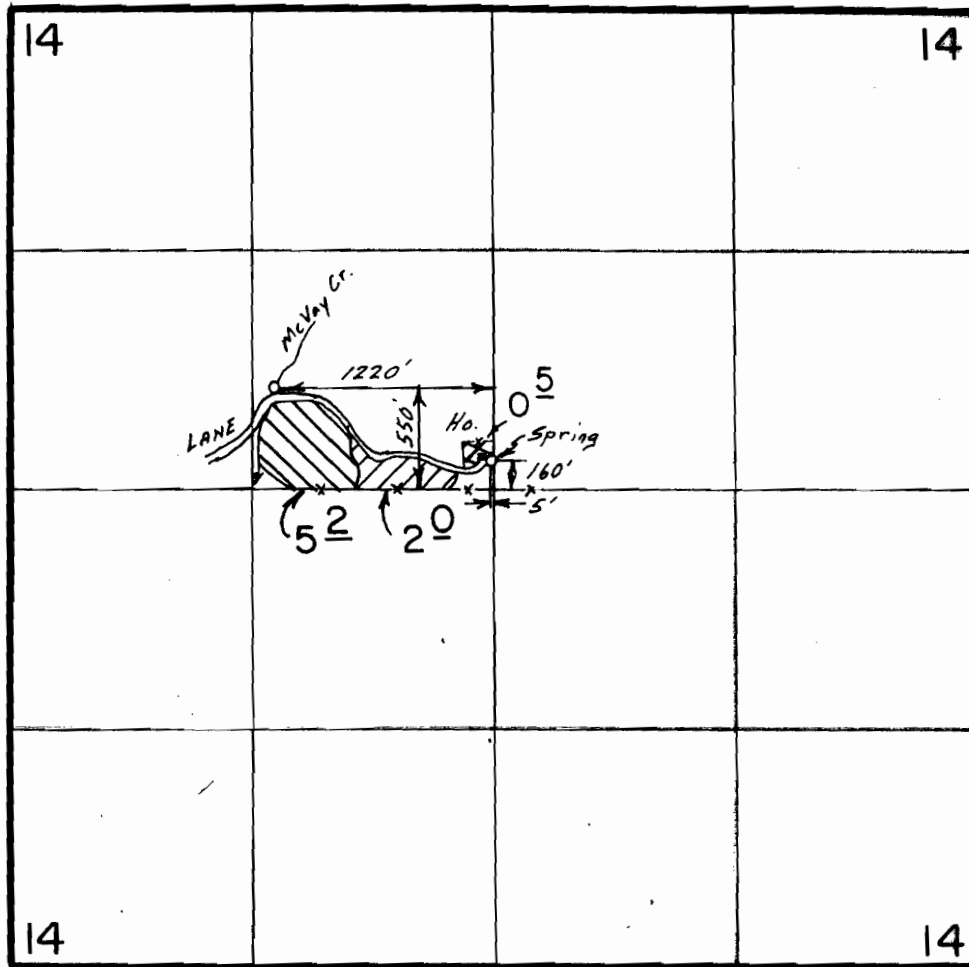

Scale 1" = 1320'

GERLACH —  Spring
 McVay Creek
GAGNON —  SPRING

FINAL PROOF SURVEY
UNDER

Application No. 57736. Permit No. 43885.....
IN NAME OF

JOSEPH & THERESA GAGNON & RANDALL GERLACH