


T.29S., R.5W., W.M.

SEC. 28

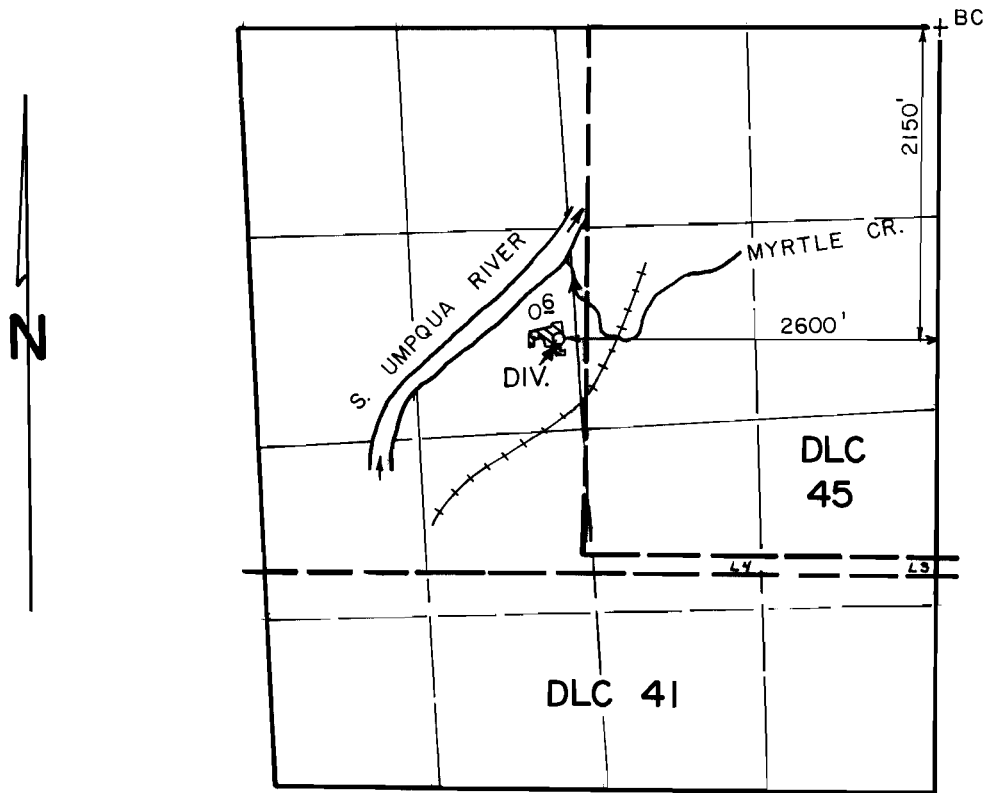

SCALE: 4" = 1 mile

**FINAL PROOF SURVEY**  
UNDER

Application No. .58398. Permit No. .44020.....  
IN NAME OF

CITY OF MYRTLE CREEK.....

Surveyed MAY...22, 19.84, by .D...CLARK.....