


T. 15., R. 39E., W. M.

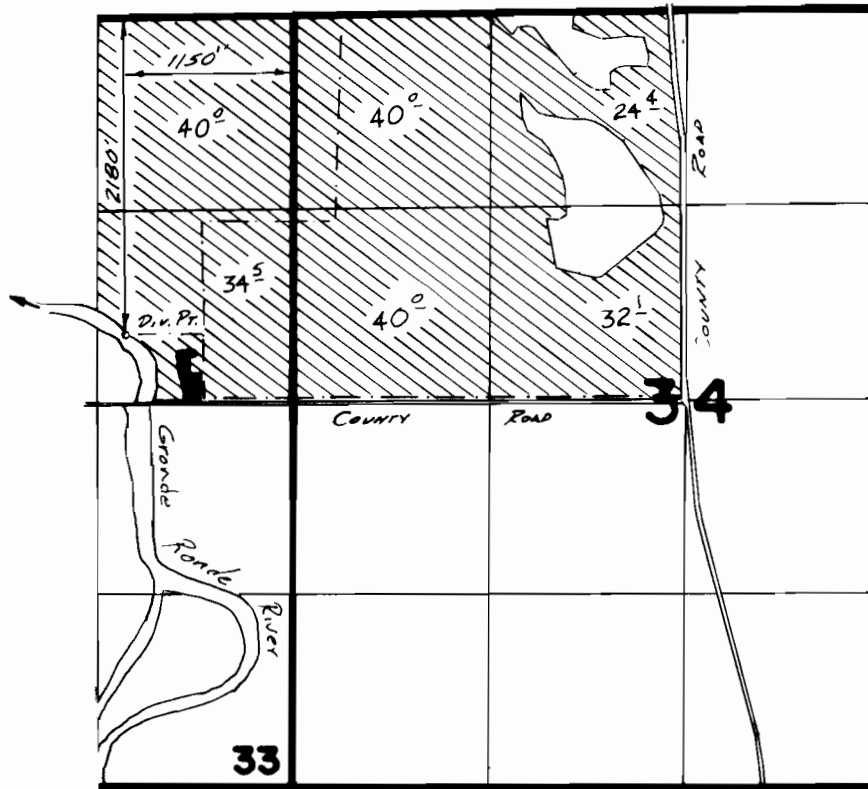

**FINAL PROOF SURVEY**  
UNDER

Application No. **58535** Permit No. **44154**  
IN NAME OF

.....**HOWARD A. BINGAMAN**.....

Surveyed *Aug. 22* 1983, by *V. L. Church*.....